

TOWNSHIP 6 SOUTH & 7 SOUTH
RANGE 3 WEST, W.M.

Marion County

KEIZER

SALEM

CITY LIMITS

NEW REITZ WELL #16

ABANDONED REITZ WELL #16

REITZ LINE

NOTE: MAP IS FOR SOLE PURPOSE OF IDENTIFYING LOCATION OF WATER RIGHT AND HAS NO INTENT TO DIMENSION OR LOCATE ANY PROPERTY OWNERSHIP LINES

WATER USE AREA-

APPLICATION G-15729

PERMIT NO. G-15369

0 660 1320 2640

SCALE: 1" = 2640' 0"

CITY OF KEIZER
REITZ WELL
WATER RIGHTS MAP
DECEMBER 19, 2023

WATER USE AREA- 

PERMIT NO. G-15369

A horizontal number line with four major tick marks labeled 0, 660, 1320, and 2640. The line is divided into three equal segments by these tick marks. The segment between 1320 and 2640 is shaded black.

SCALE: 1" = 2640' 0"

CITY OF KEIZER
REITZ WELL
WATER RIGHTS MAP
DECEMBER 19, 2023

NEW REITZ WELL IS 890'-0" SOUTH AND 2,319'-0" WEST FROM THE SE CORNER OF TOWNSHIP 6S, RANGE 3W, SECTION 23.

FEB 05 2024

14400 -

OWRD

06 3W 23DC
KEIZER



MARION COUNTY, OREGON
SW 1/4 SE 1/4 SEC 26 T6S R3W W.M.
SCALE 1" = 100'

LEGEND

LINE TYPES

- Historical Boundary
- Parcel Boundary
- Road Right-of-Way
- Railroad Right-of-Way
- Private Road ROW
- Subdivision/Plat Boundary
- Waterline - Lot Boundary
- Waterline - Non Boundary

CORNER TYPES

- 1/4 Section Corner
- 1/16th Section Corner
- DLC Corner
- 16, 15
- Section Corner
- 21, 22

NUMBERS

Tax Code Number

00.00.0

00.00.0

NOTES

Tick Marks: A tick mark in the road indicates that the labelled dimension extends into the public ROW

CANCELLED NUMBERS

100
110
DISCLAIMER: THIS MAP WAS PREPARED FOR ASSESSMENT PURPOSES ONLY



FOR ADDITIONAL MAPS VISIT OUR WEBSITE AT
www.marion.or.us

PLOT DATE: 5/12/2021

KEIZER

06 3W 23DC

06 3W 23DC

RECEIVED

FEB 05 2024


OWRD

CLEAR


06 3W 23DC

T.6S. & 7S., R.3W., W.M

Application No. 15729
Permit No. G-15369

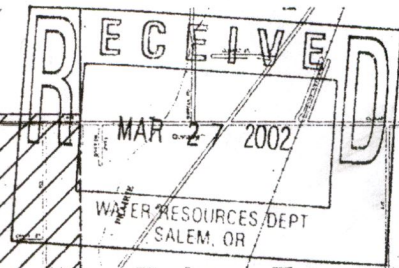


1000 0 1000 2000 feet

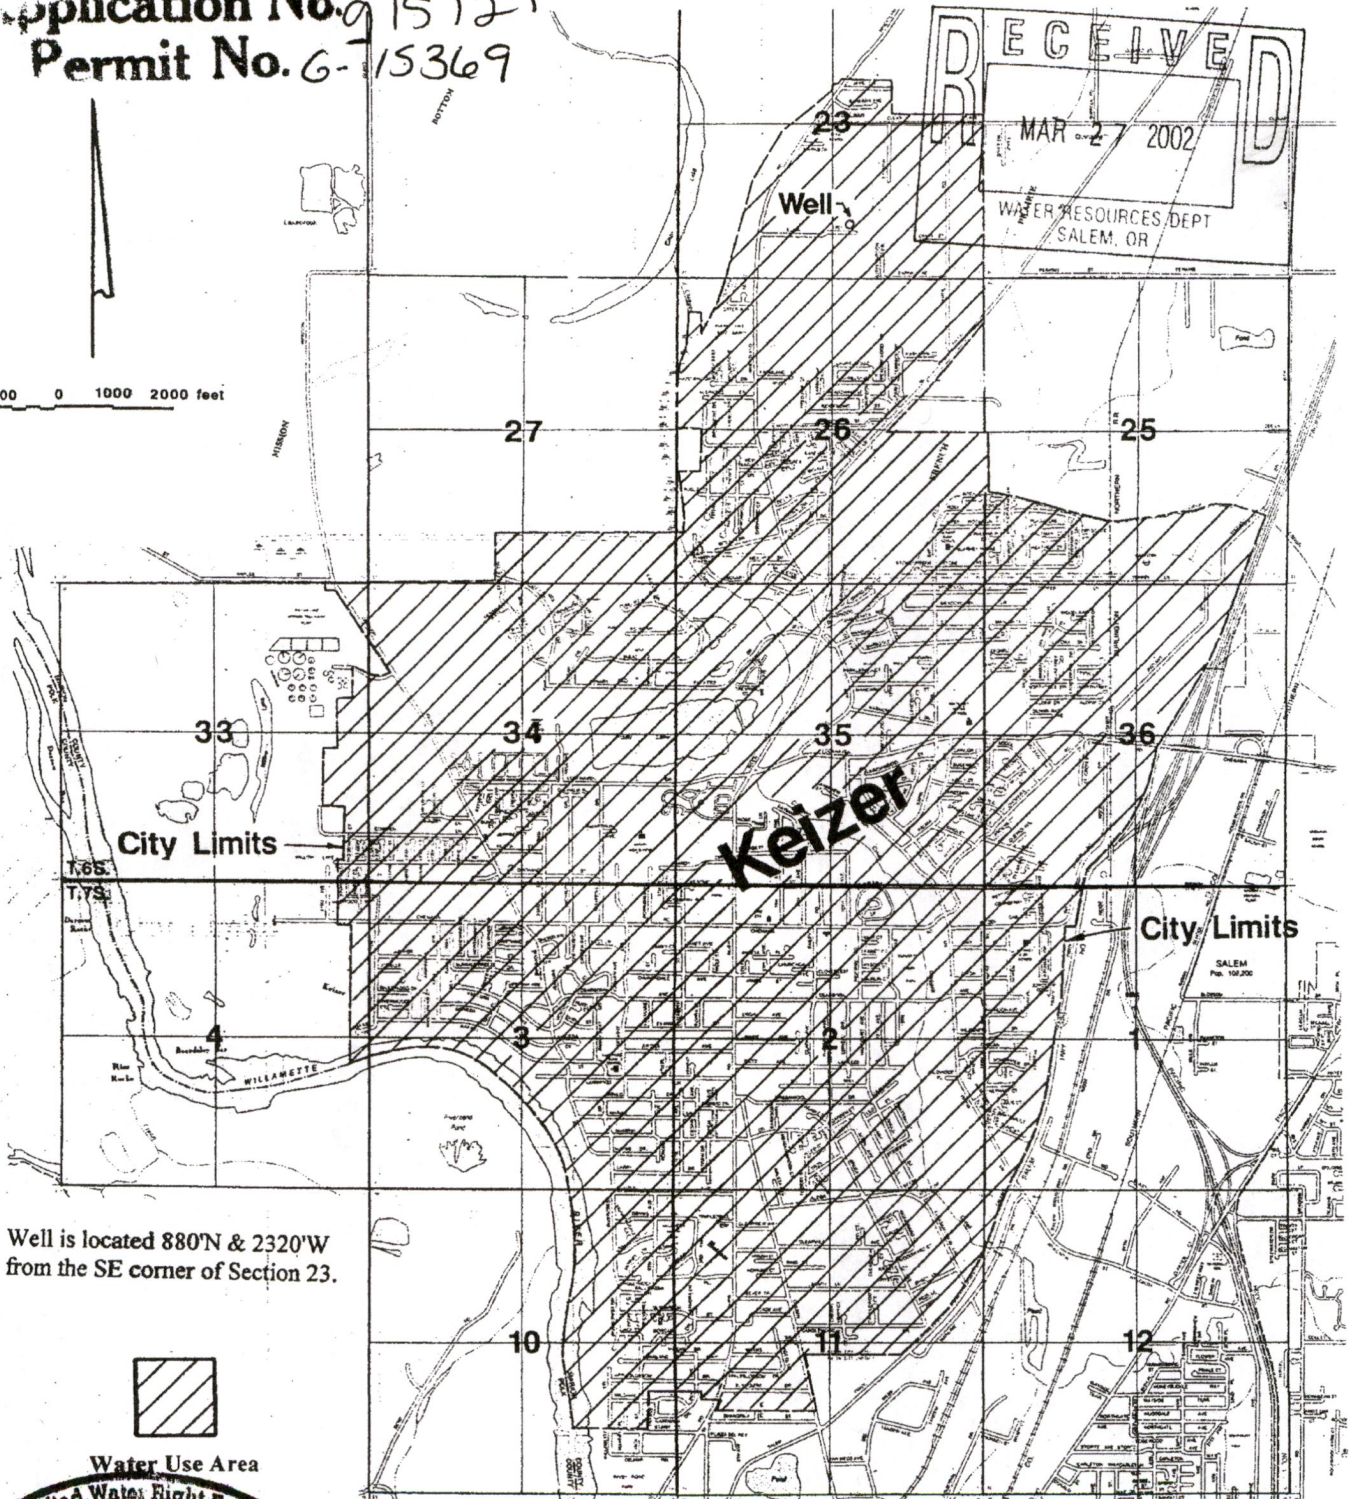

Well is located 880'N & 2320'W
from the SE corner of Section 23.



Water Use Area

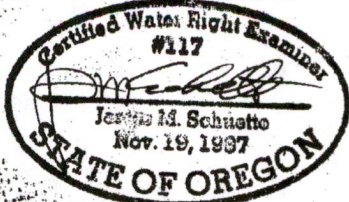

This Map Was Prepared For The Purpose Of Identifying The
Location Of A Water Right Only And Is Not Intended To Provide
Legal Dimensions Or Location Of Property Ownership Lines.

Application Map

City of Keizer

Application #:

Permit #:

RECEIVED

FEB 05 2024

OWRD

14400