


# T.21S. R.1W., W.M.

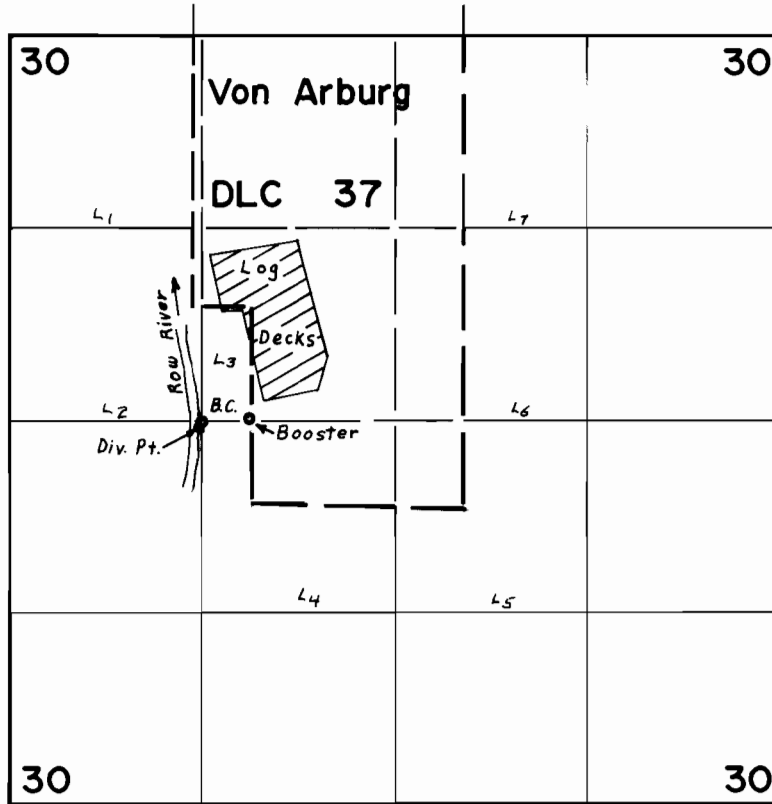

Div. Pt. Loc. 30' S. & 30' W. From S.W. Cor SE<sup>4</sup> NW<sup>4</sup> Sec 30

## FINAL PROOF SURVEY UNDER

Transfer No. 2883  
Application No. .... Permit No. ....  
IN NAME OF

.....BOHEMIA, INC.....

Surveyed MAR. 27. 1978., by J.S. DONALDSON