T.24S.,R.7W.,W.M.

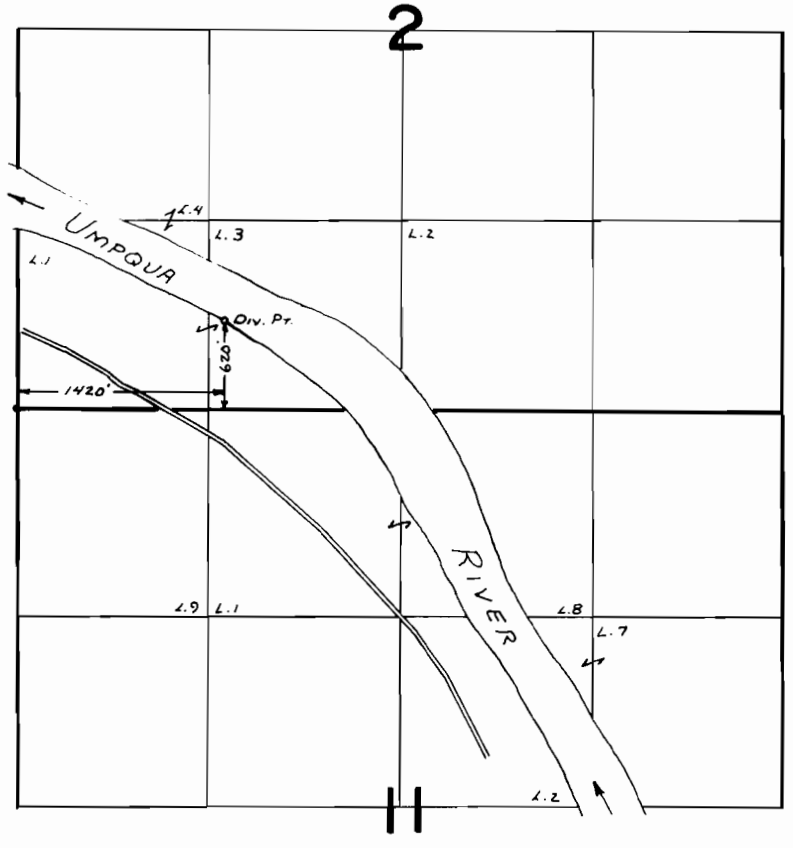

FINAL PROOF SURVEY
UNDER

Transfer No. 2899
Application No. ..... Permit No. .....
IN NAME OF

MILO BULLOCK

Surveyed JUNE 4 19 75, by L. E. GOULD

BTR-3AA-42 LMT