90684

T. 24S., R. 7 W., W.M.

SECTION 2

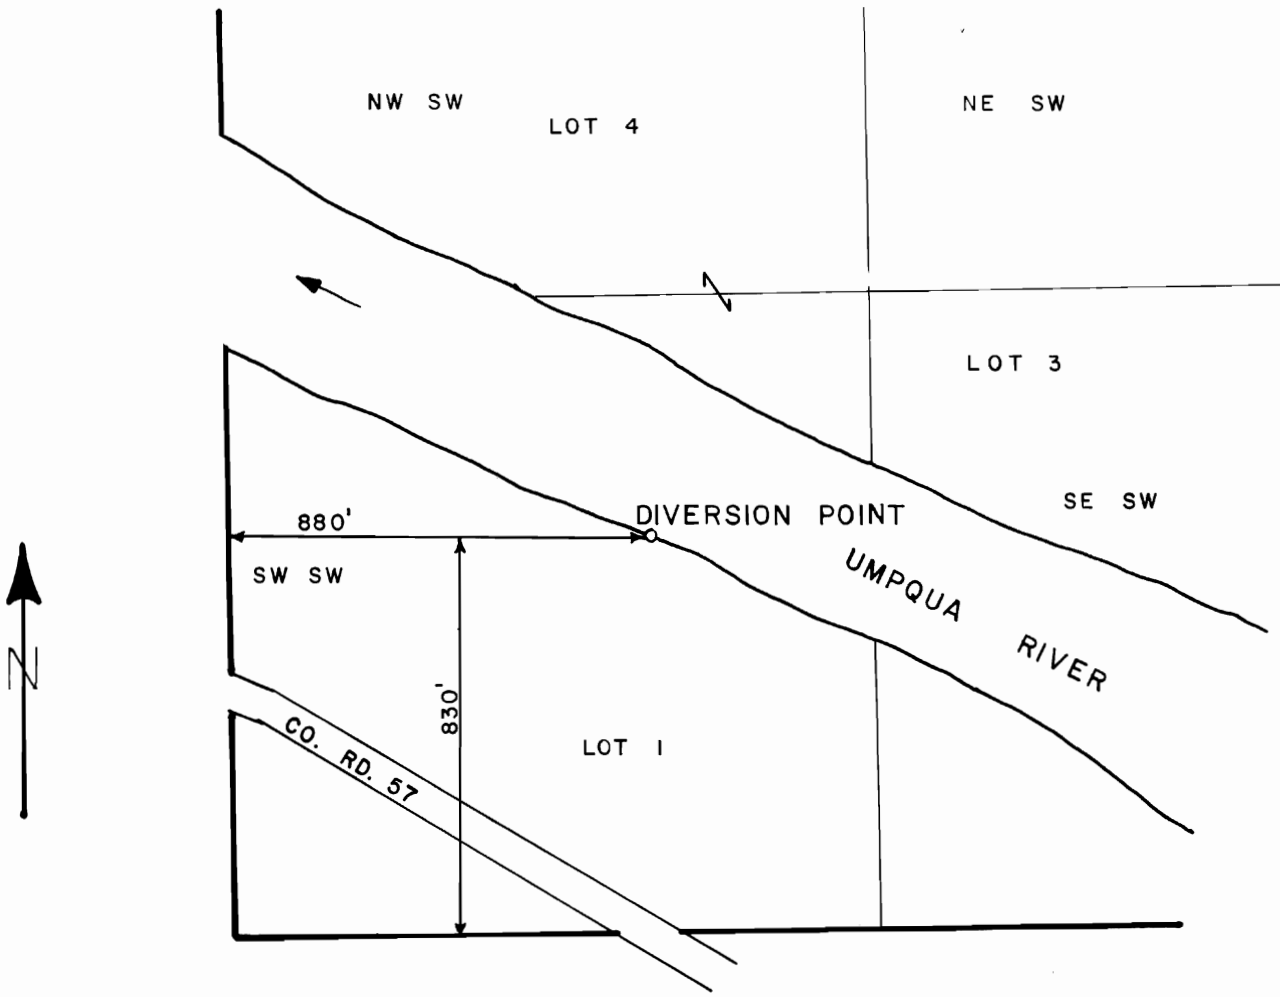

SCALE: 1" = 400'

FINAL PROOF SURVEY

UNDER

TRANSFER NUMBER 4015

IN NAME OF

JOSEPH H. & HELEN W. STETSON

Surveyed AUG. 12 **1987., by** J. KAUPPILA

PHOTO: 78-36-62/ZTS 10/27/87 jk