T.1S.,R.4W.,W.M.

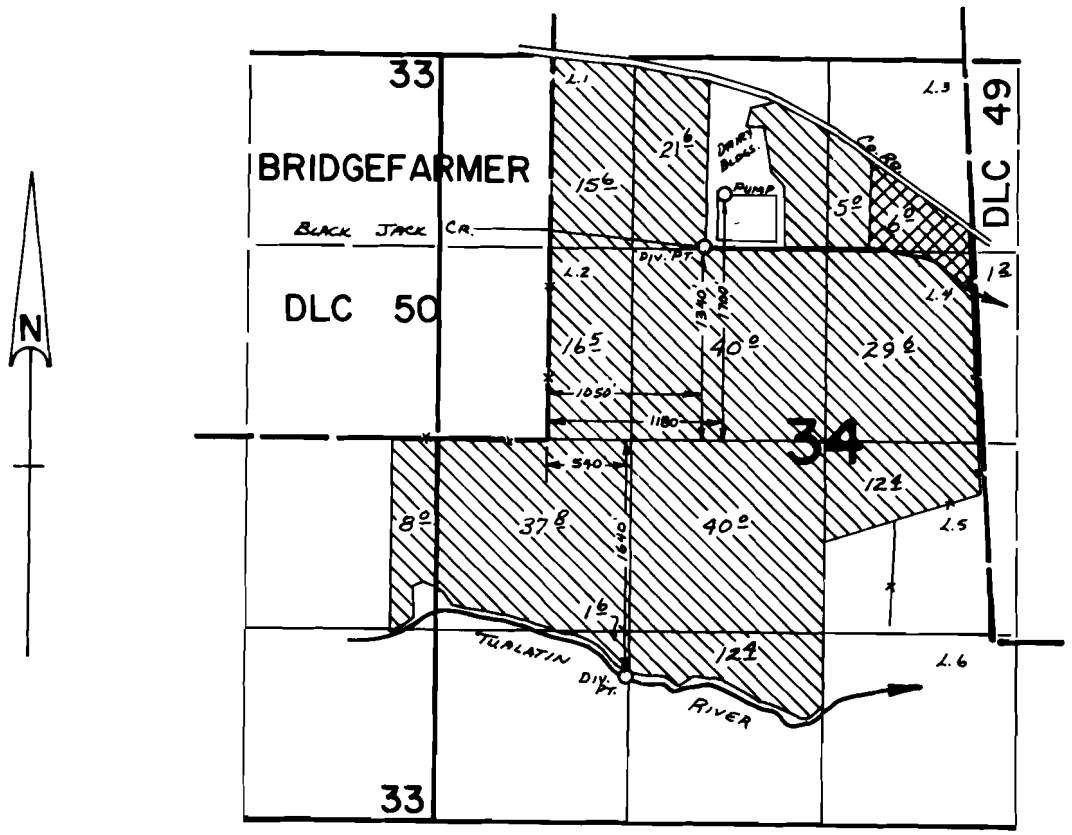

SCALE: 1" = 1320'

FINAL PROOF SURVEY

UNDER

Transfer No. 4197 ▨

R-58799 R-7935

Application No. 58800 Permit No. 44405 ▨

IN NAME OF

JOHN MULHOLLAND

Surveyed Nov. 2 19.83., by L. M. TOLL

PTS 1963-1-A
PTS 1983-Y