



TOWNSHIP 13 SOUTH,
RANGE 12 EAST, W. M.

~~T 6828~~

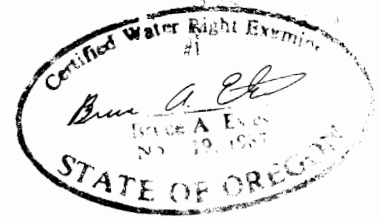

Scale 1" = 1320'

Surveyed July 23, 1992

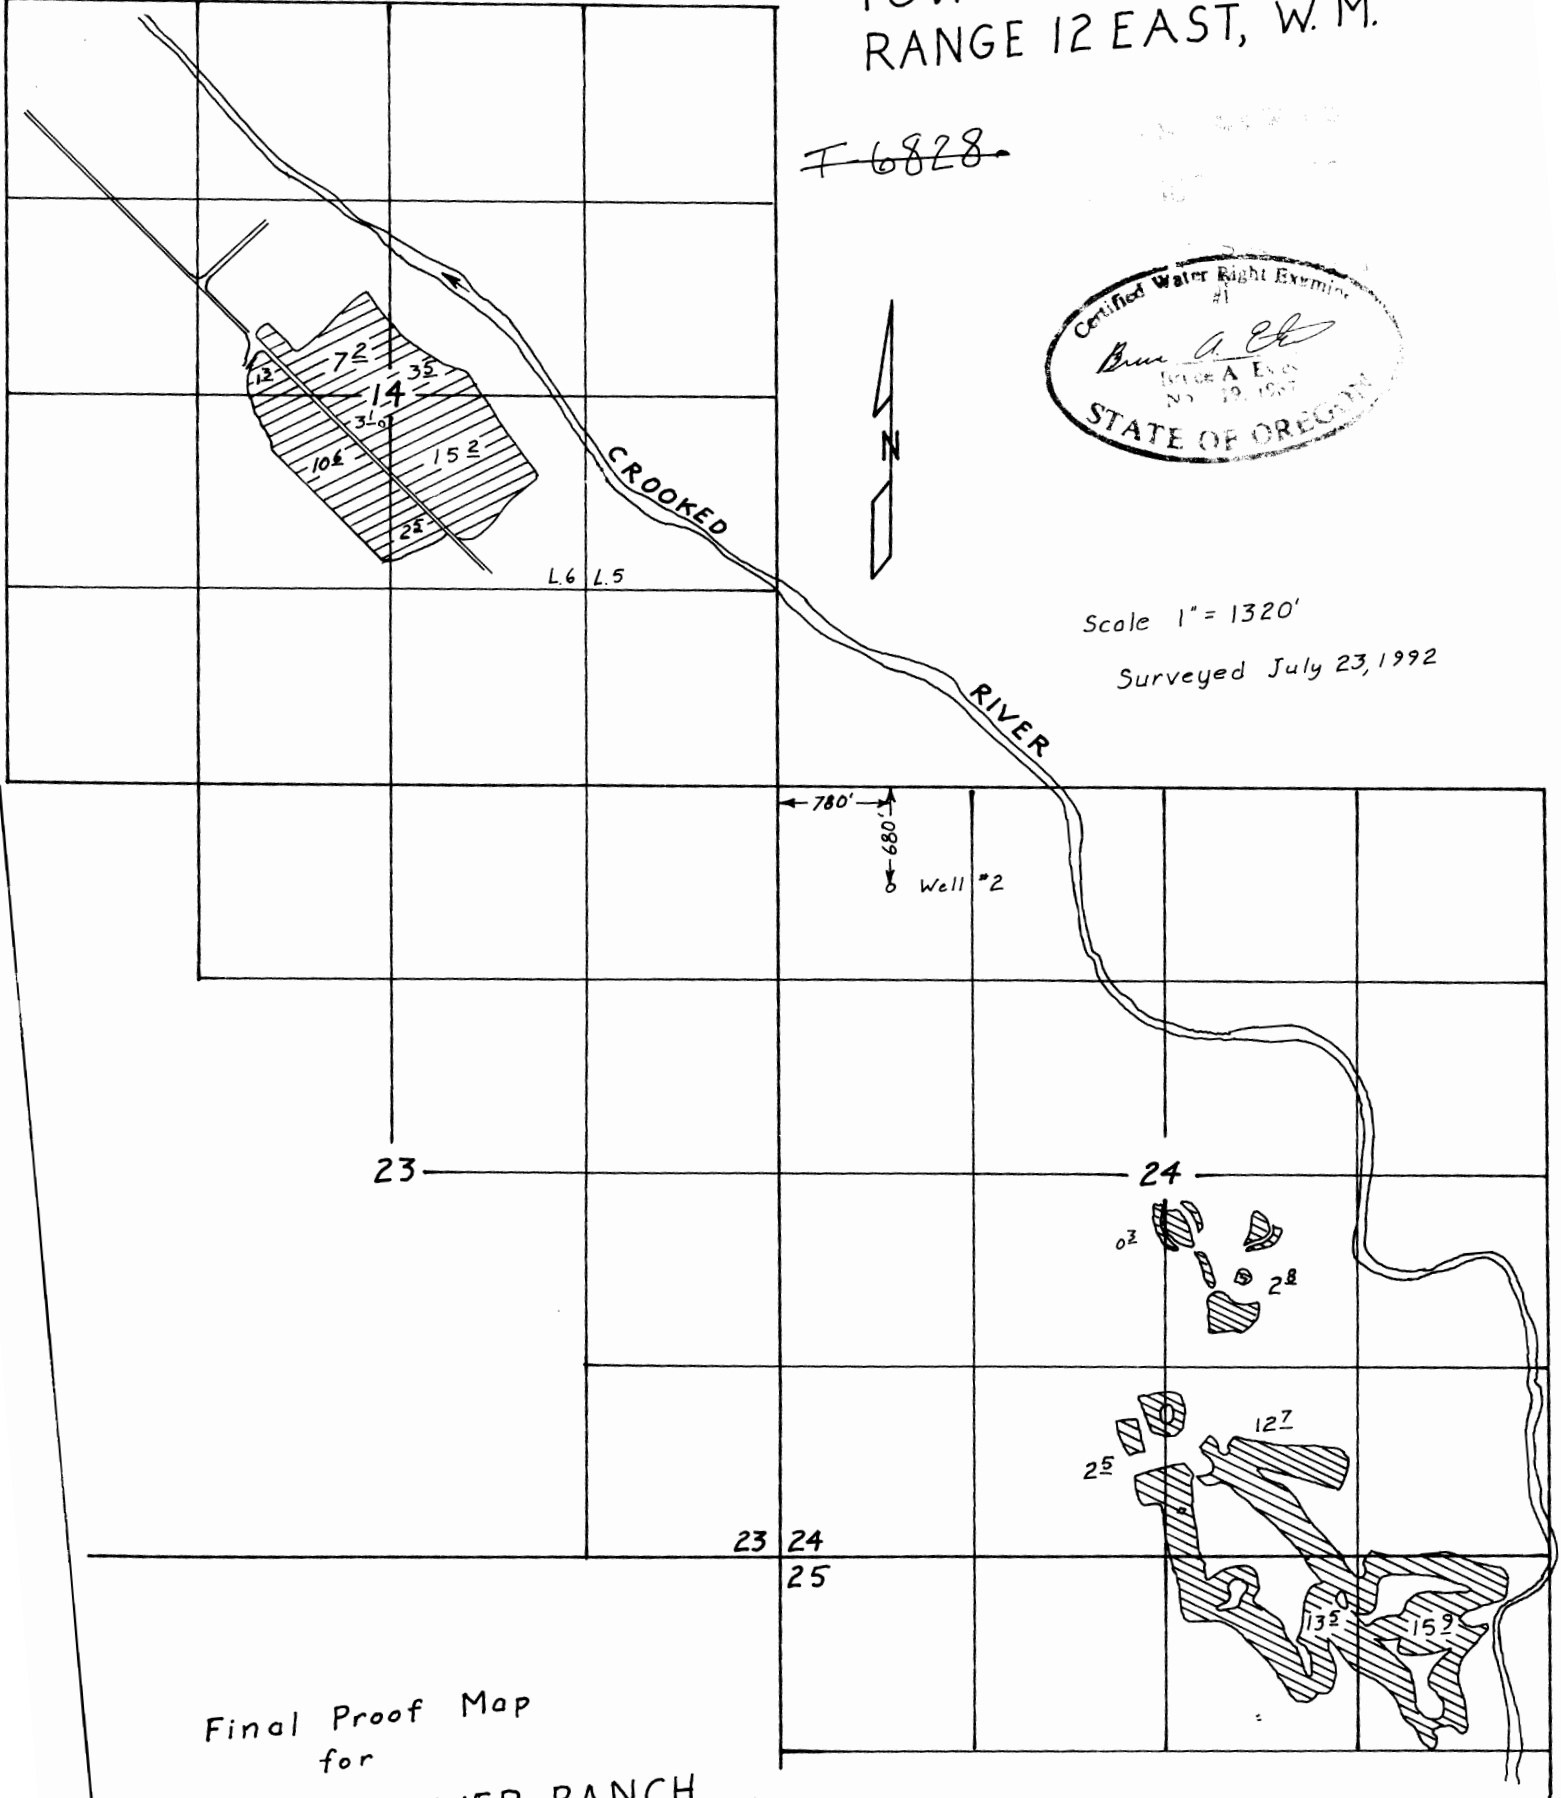

Final Proof Map
for
CROOKED RIVER RANCH
under
Transfer 6604

This map is for the purpose of locating a water right
only and has no intent to provide the location of
property lines or legal dimensions.