


**T.13S., R.3W., W.M.
SECTION 36**

RECEIVED

SEP 28 1998

**WATER RESOURCES DEPT.
Salem, Oregon**

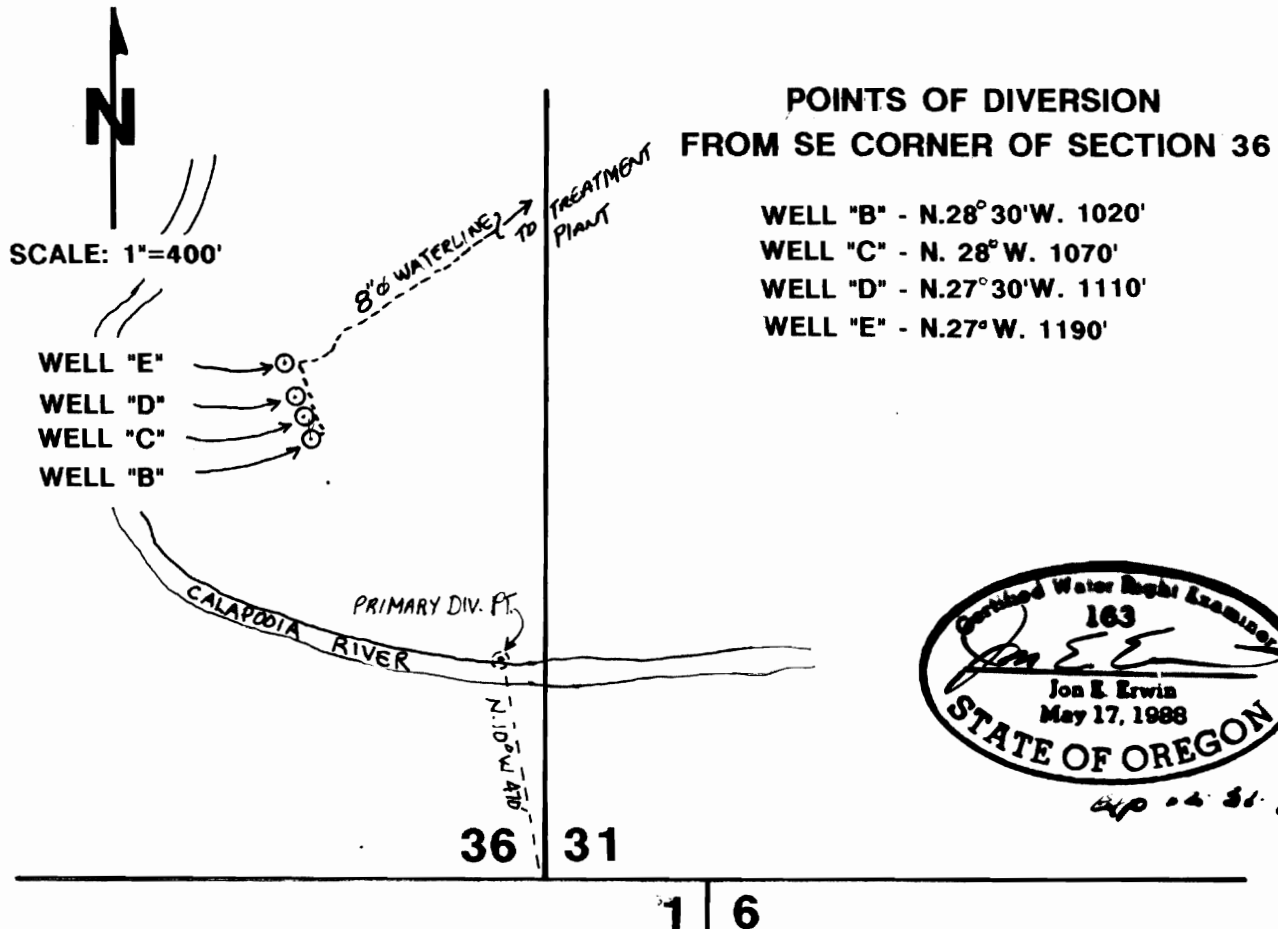

FINAL PROOF MAP

PERMIT No. T6860

IN THE NAME OF

CITY OF BROWNSVILLE

P.O. BOX 188

BROWNSVILLE, OR 97327