FINAL PROOF SURVEY MAP

IN THE NAME OF KENNETH L. OR LUCINDA E. LAWSON
SECTION 32, TOWNSHIP 26 SOUTH, RANGE 6 WEST, W.M.
PERMIT 37955 CERTIFICATE 53917
TRANSFER 6937

RECEIVED
SEP 30 1997
WATER RESOURCES DEPT
SALEM, OREGON

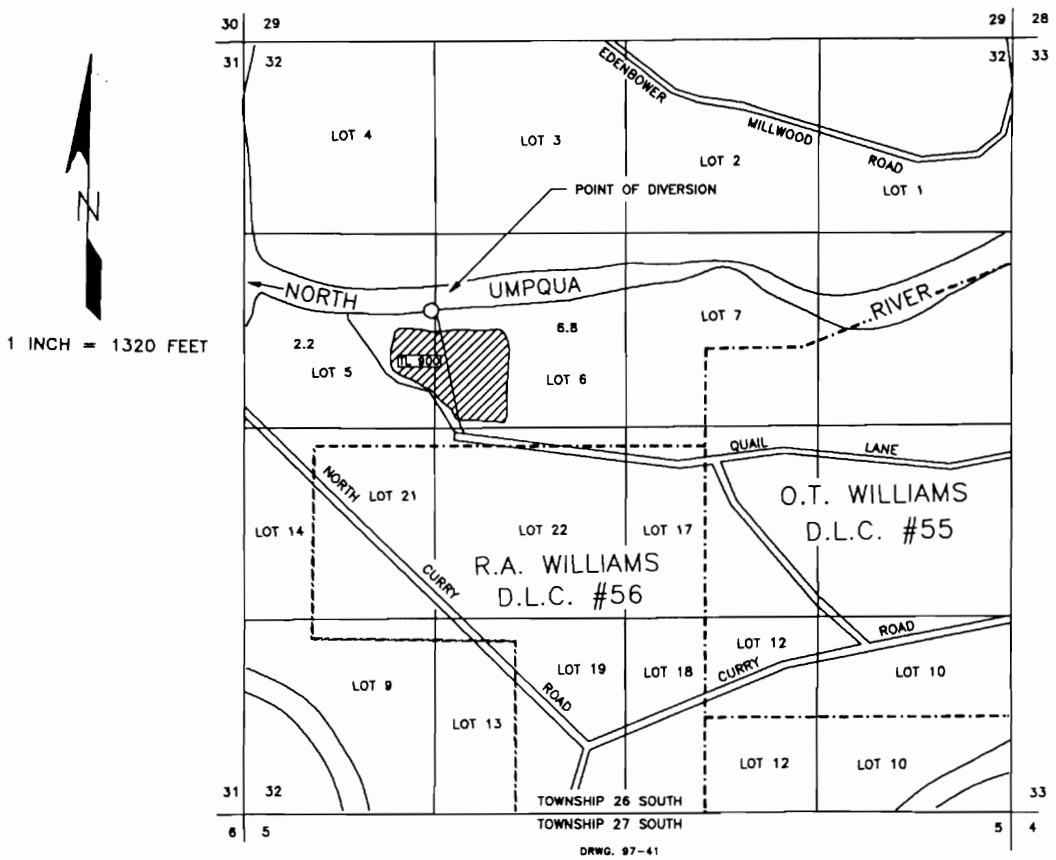

THE POINT OF DIVERSION IS LOCATED 810 FEET NORTH AND 1300 FEET EAST FROM THE WEST 1/4 CORNER OF SECTION 32, BEING WITHIN THE SW1/4 OF THE NW1/4 OF SECTION 32, BOTH POINTS OF DIVERSION BEING WITHIN TOWNSHIP 26 SOUTH, RANGE 6 WEST, W.M., DOUGLAS COUNTY.

THE PURPOSE OF THIS MAP IS TO IDENTIFY THE LOCATION OF THE WATER RIGHT. IT IS NOT INTENDED TO PROVIDE INFORMATION RELATIVE TO THE LOCATION OF PROPERTY OWNERSHIP BOUNDARY LINES.

Certified Water Right Examiner
#054 WRE
James P. Gleason
Nov. 19, 1987
STATE OF OREGON