

Application Map
for
City of Yachats
Lincoln County Oregon.

Application No. 69856
Permit No. ~~51124~~
51190




Scale 4 inches = 1 mile

RECEIVED

MAY 30 1997

WATER RESOURCES DEPT.
SALEM, OREGON

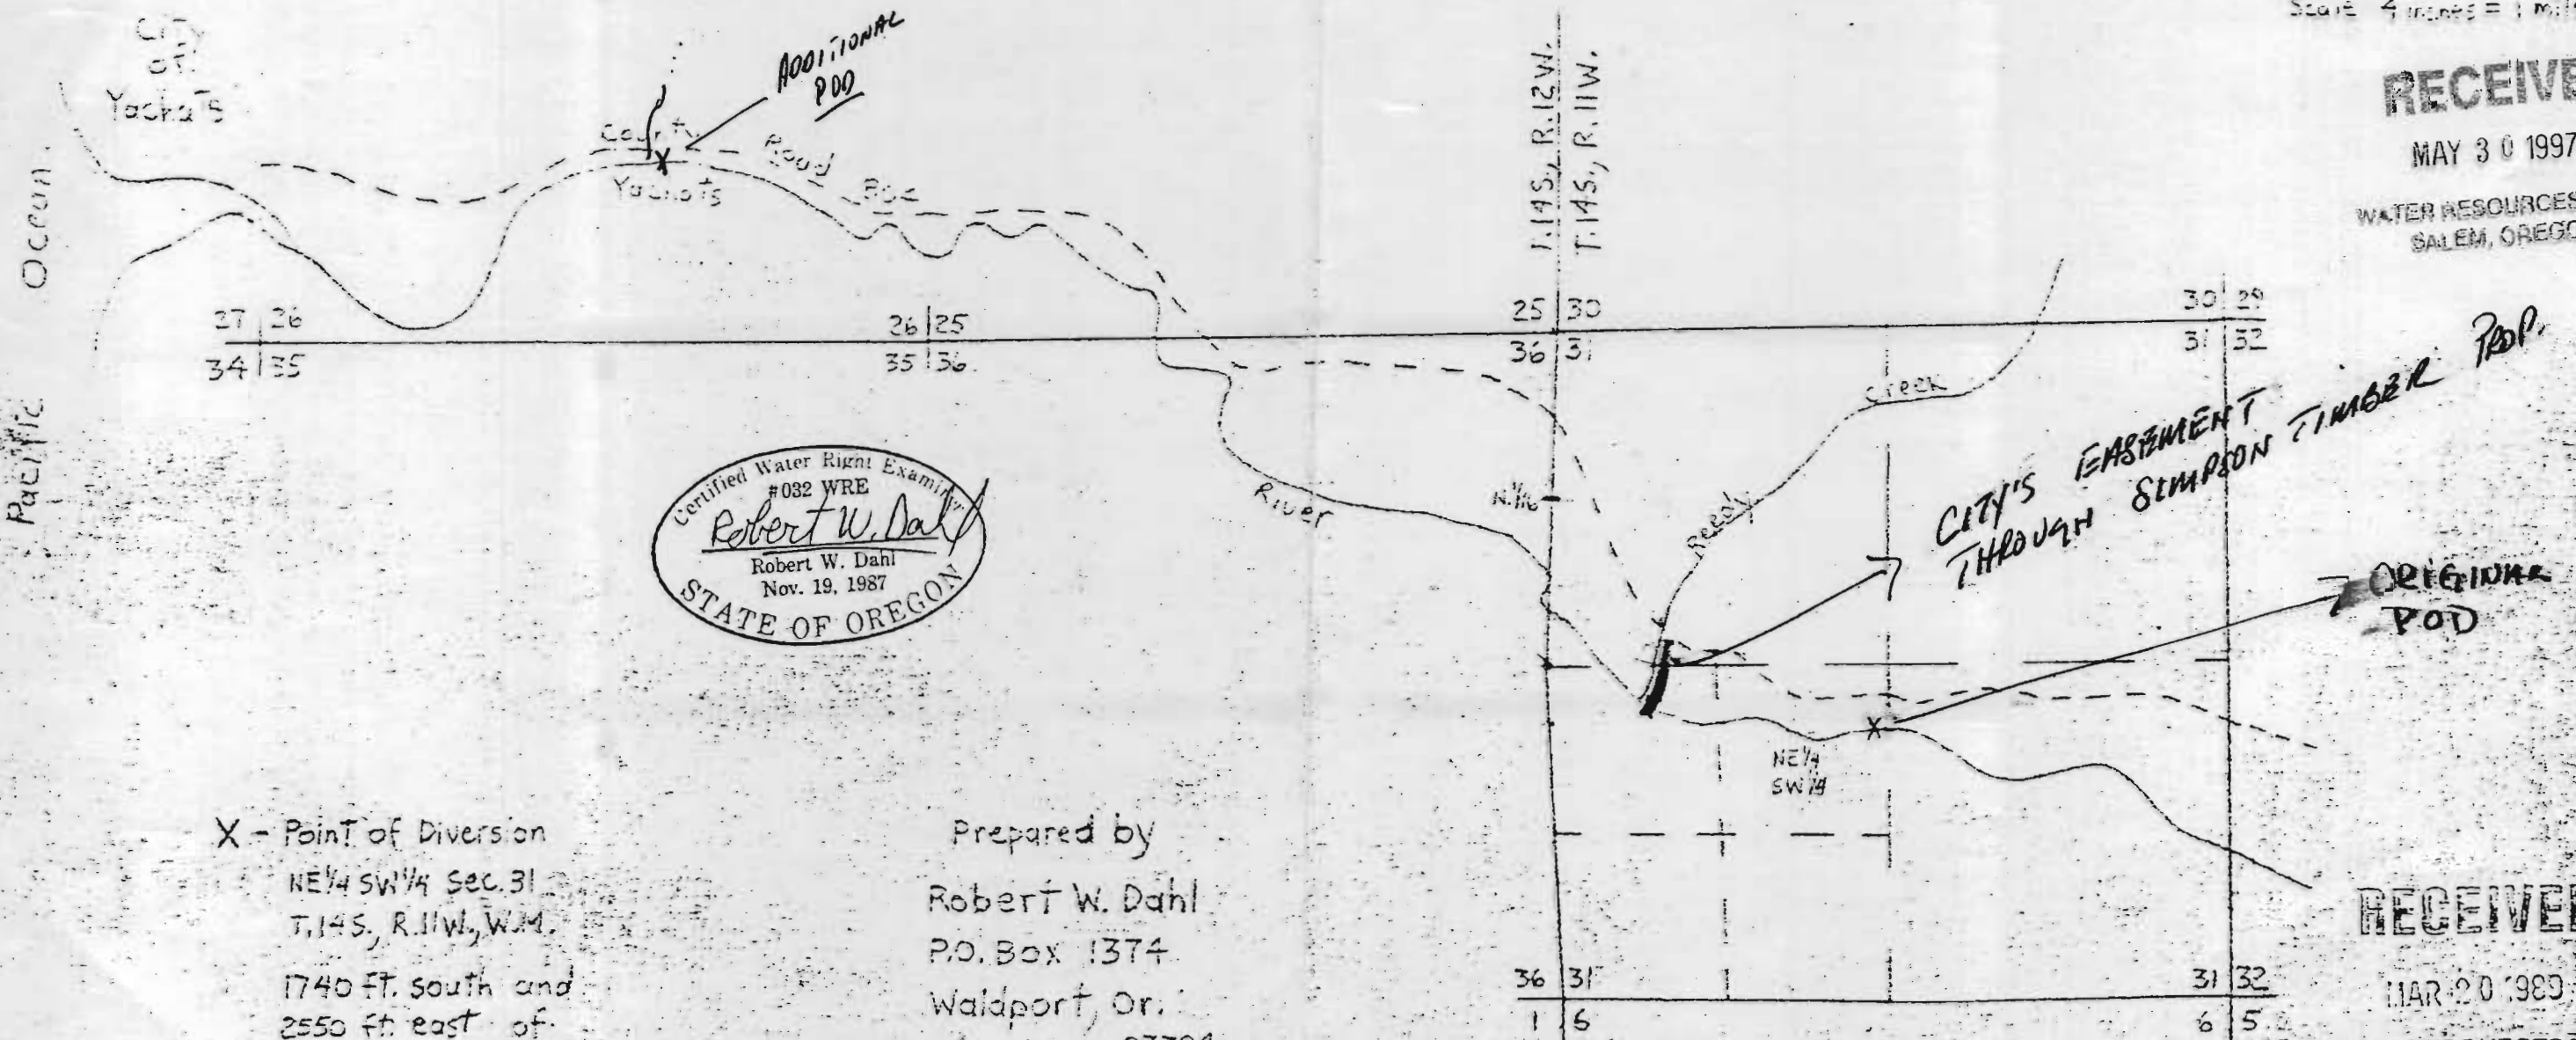

X - Point of Diversion
NE 1/4 SW 1/4 Sec. 31
T.14S., R.11W., W.M.
1740 ft. south and
2550 ft. east of
N. 1/4 sec. cor. of
secs. 31+36, T.14S., R.11W.,
March 8, 1989

Prepared by
Robert W. Dahl
P.O. Box 1374
Waldport, Or.
97394

RECEIVED

MAR 20 1989

WATER RESOURCES DEPT.
SALEM, OREGON