
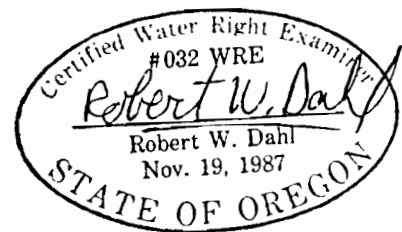
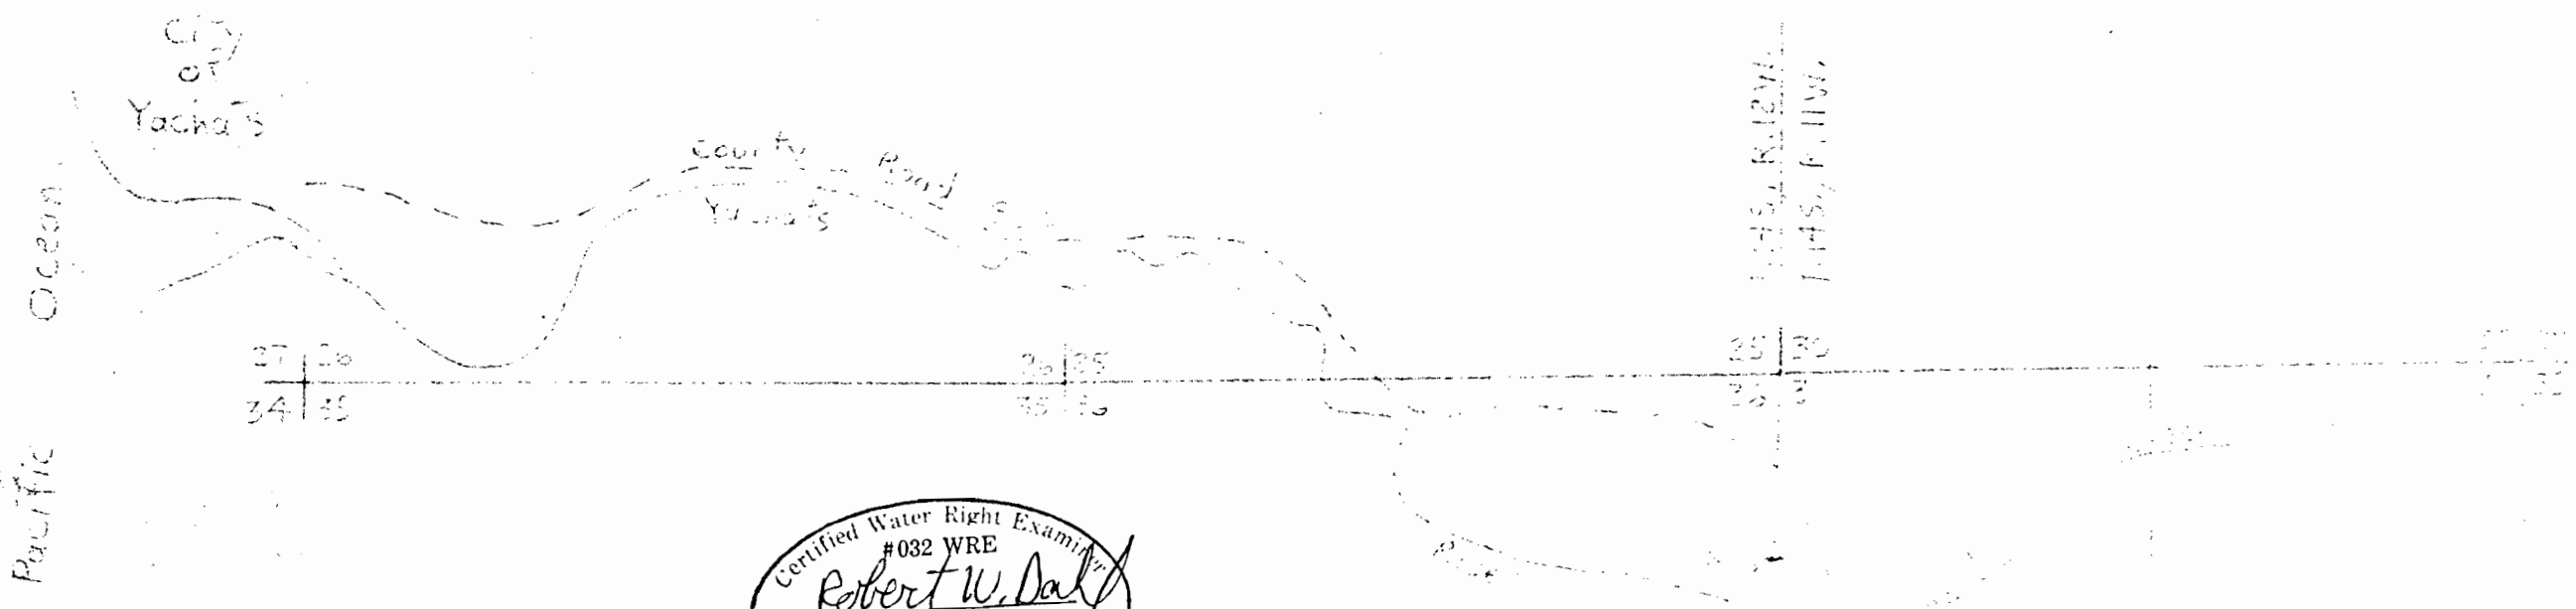


T 7967

X- NEW POINT OF DIVISION
NW 1/4 SW 1/4
T14S - R11W - SEC. 31
1740 FT SOUTH AND
1159 FT EAST ON
N 1/16 SEC. COR. OF
SEC. 31 & 36 T14S - R11W & 12W

Application Map
for
City of Yachats
Lincoln County Oregon


Application No. ~~67856~~
Permit No. ~~51124~~

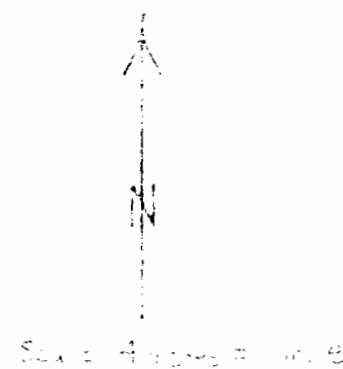

X - Point of Division
NW 1/4 SW 1/4
T14S - R11W - SEC. 31
1740 FT. SOUTH AND
1159 FT. EAST ON
N 1/16 SEC. COR. OF
SEC. 31 & 36 T14S - R11W & 12W

Prepared by
Robert W. Dahl
Box 37
Yachats, OR

RECEIVED
MAR 30 1998
WATER RESOURCES DEPT.
SALEM, OREGON

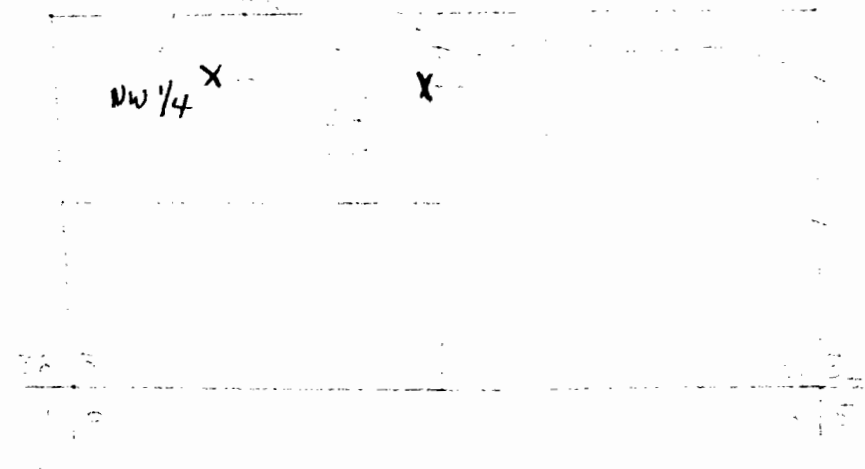

RECEIVED
MAR 30 1988
WATER RESOURCES DEPT.
SALEM, OREGON