


T.3&4S., R4W., W.M.

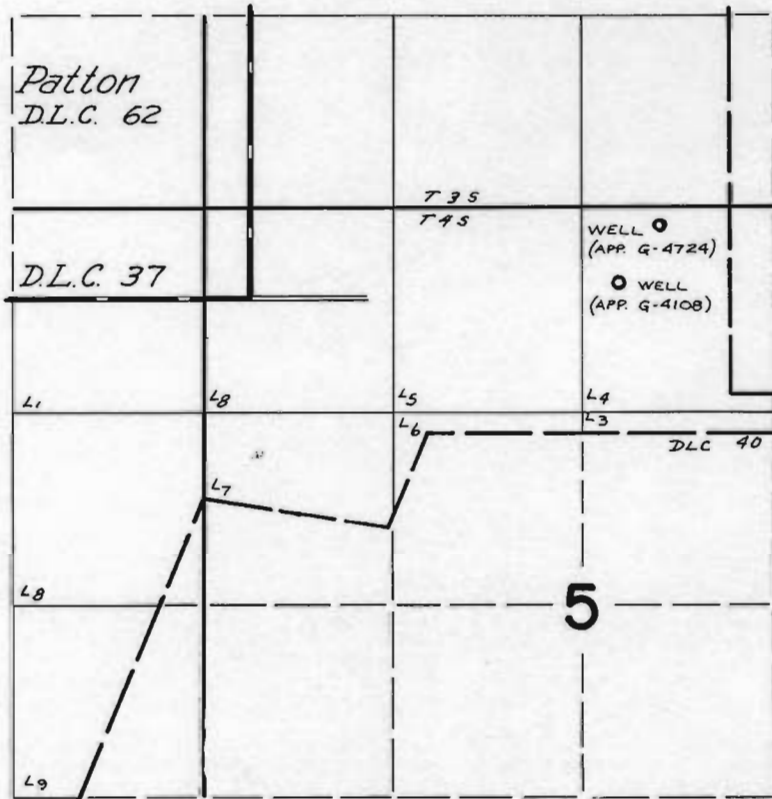

WELLS LOCATED: 100' N & 2570' E FROM SE COR PATTON DLC 37
 500' N & 2850' E FROM SE COR PATTON DLC 37

FINAL PROOF SURVEY
 UNDER

Application No. G-4108 G-4724 Permit No. G-3856 G-4647
 IN NAME OF

CITY OF LAFAYETTE

Surveyed Oct. 25 1972, by D. Norby