T. 21 S. R. 1 W. WM

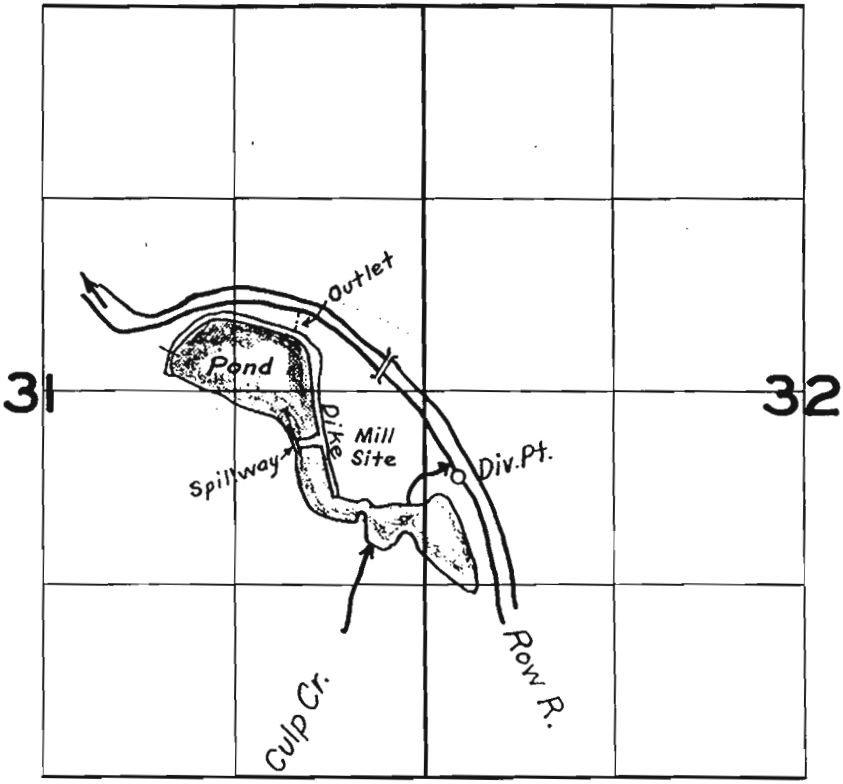

FINAL PROOF SURVEY

UNDER

19944 R-25382 R-1204

19945

Application No. 25570 Permit No. 20511

IN NAME OF

Bohemia Lumber Co. Inc

Surveyed May 4 19 54, by T. Jones