


T.4S., R.2W., W.M.

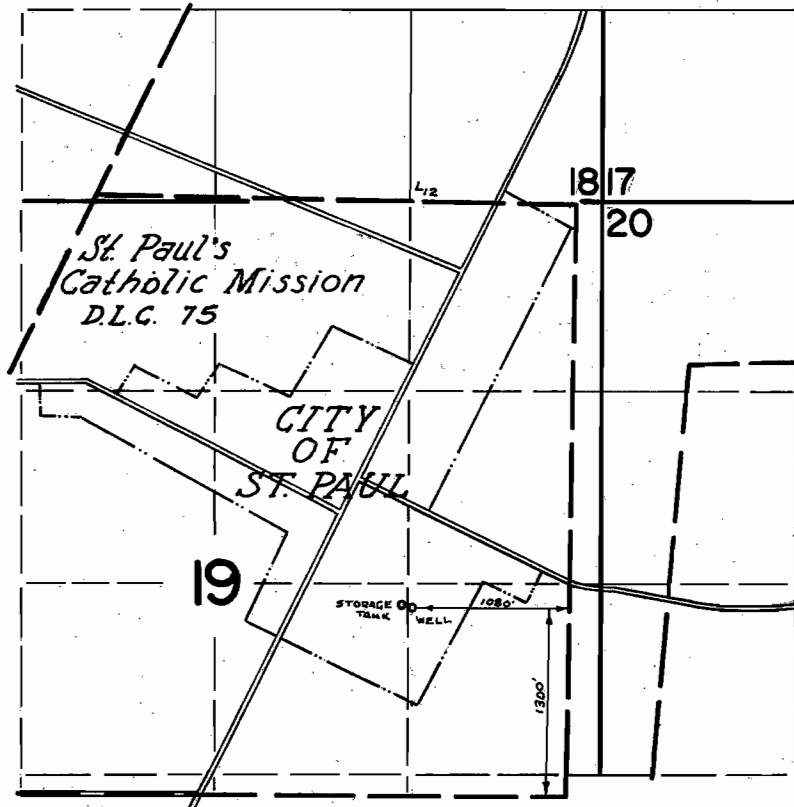

FINAL PROOF SURVEY

UNDER

Application No. G-4594 Permit No. G-4047
IN NAME OF _____

CITY OF ST. PAUL

Surveyed Oct. 3 1972, by D. Norby