
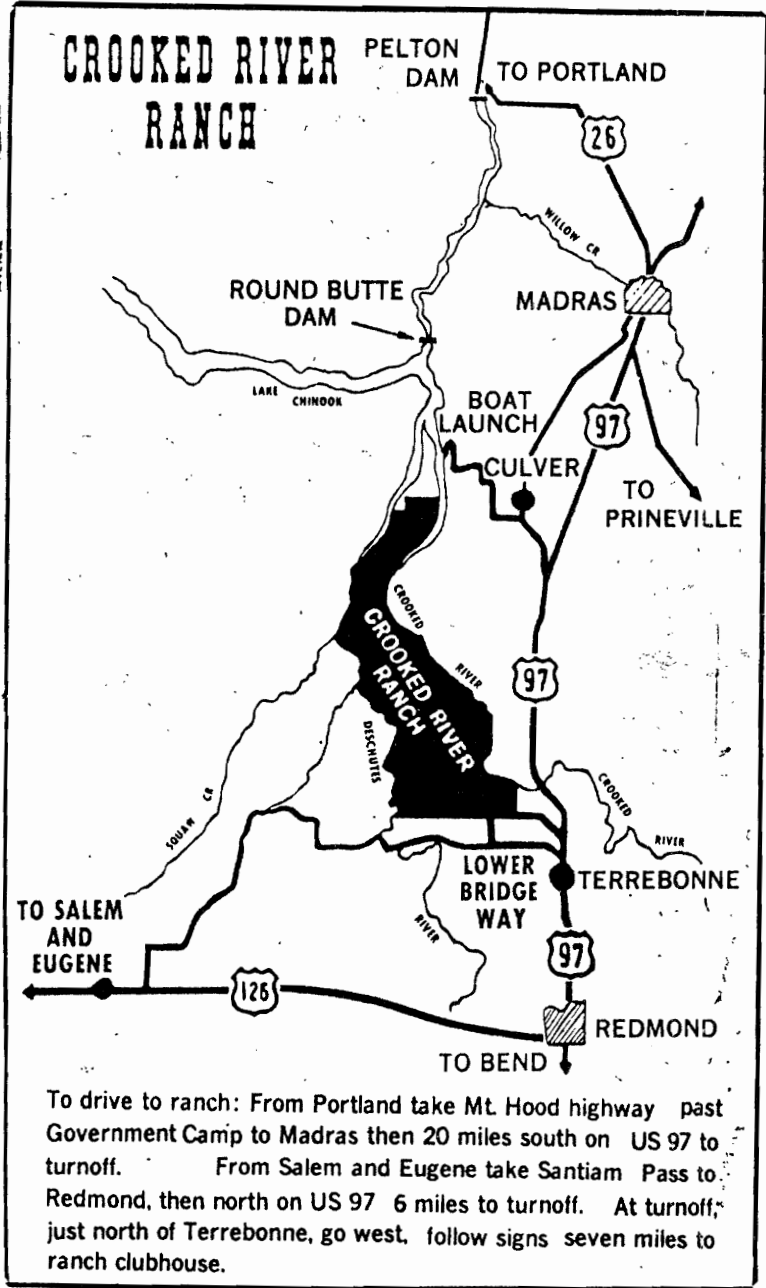


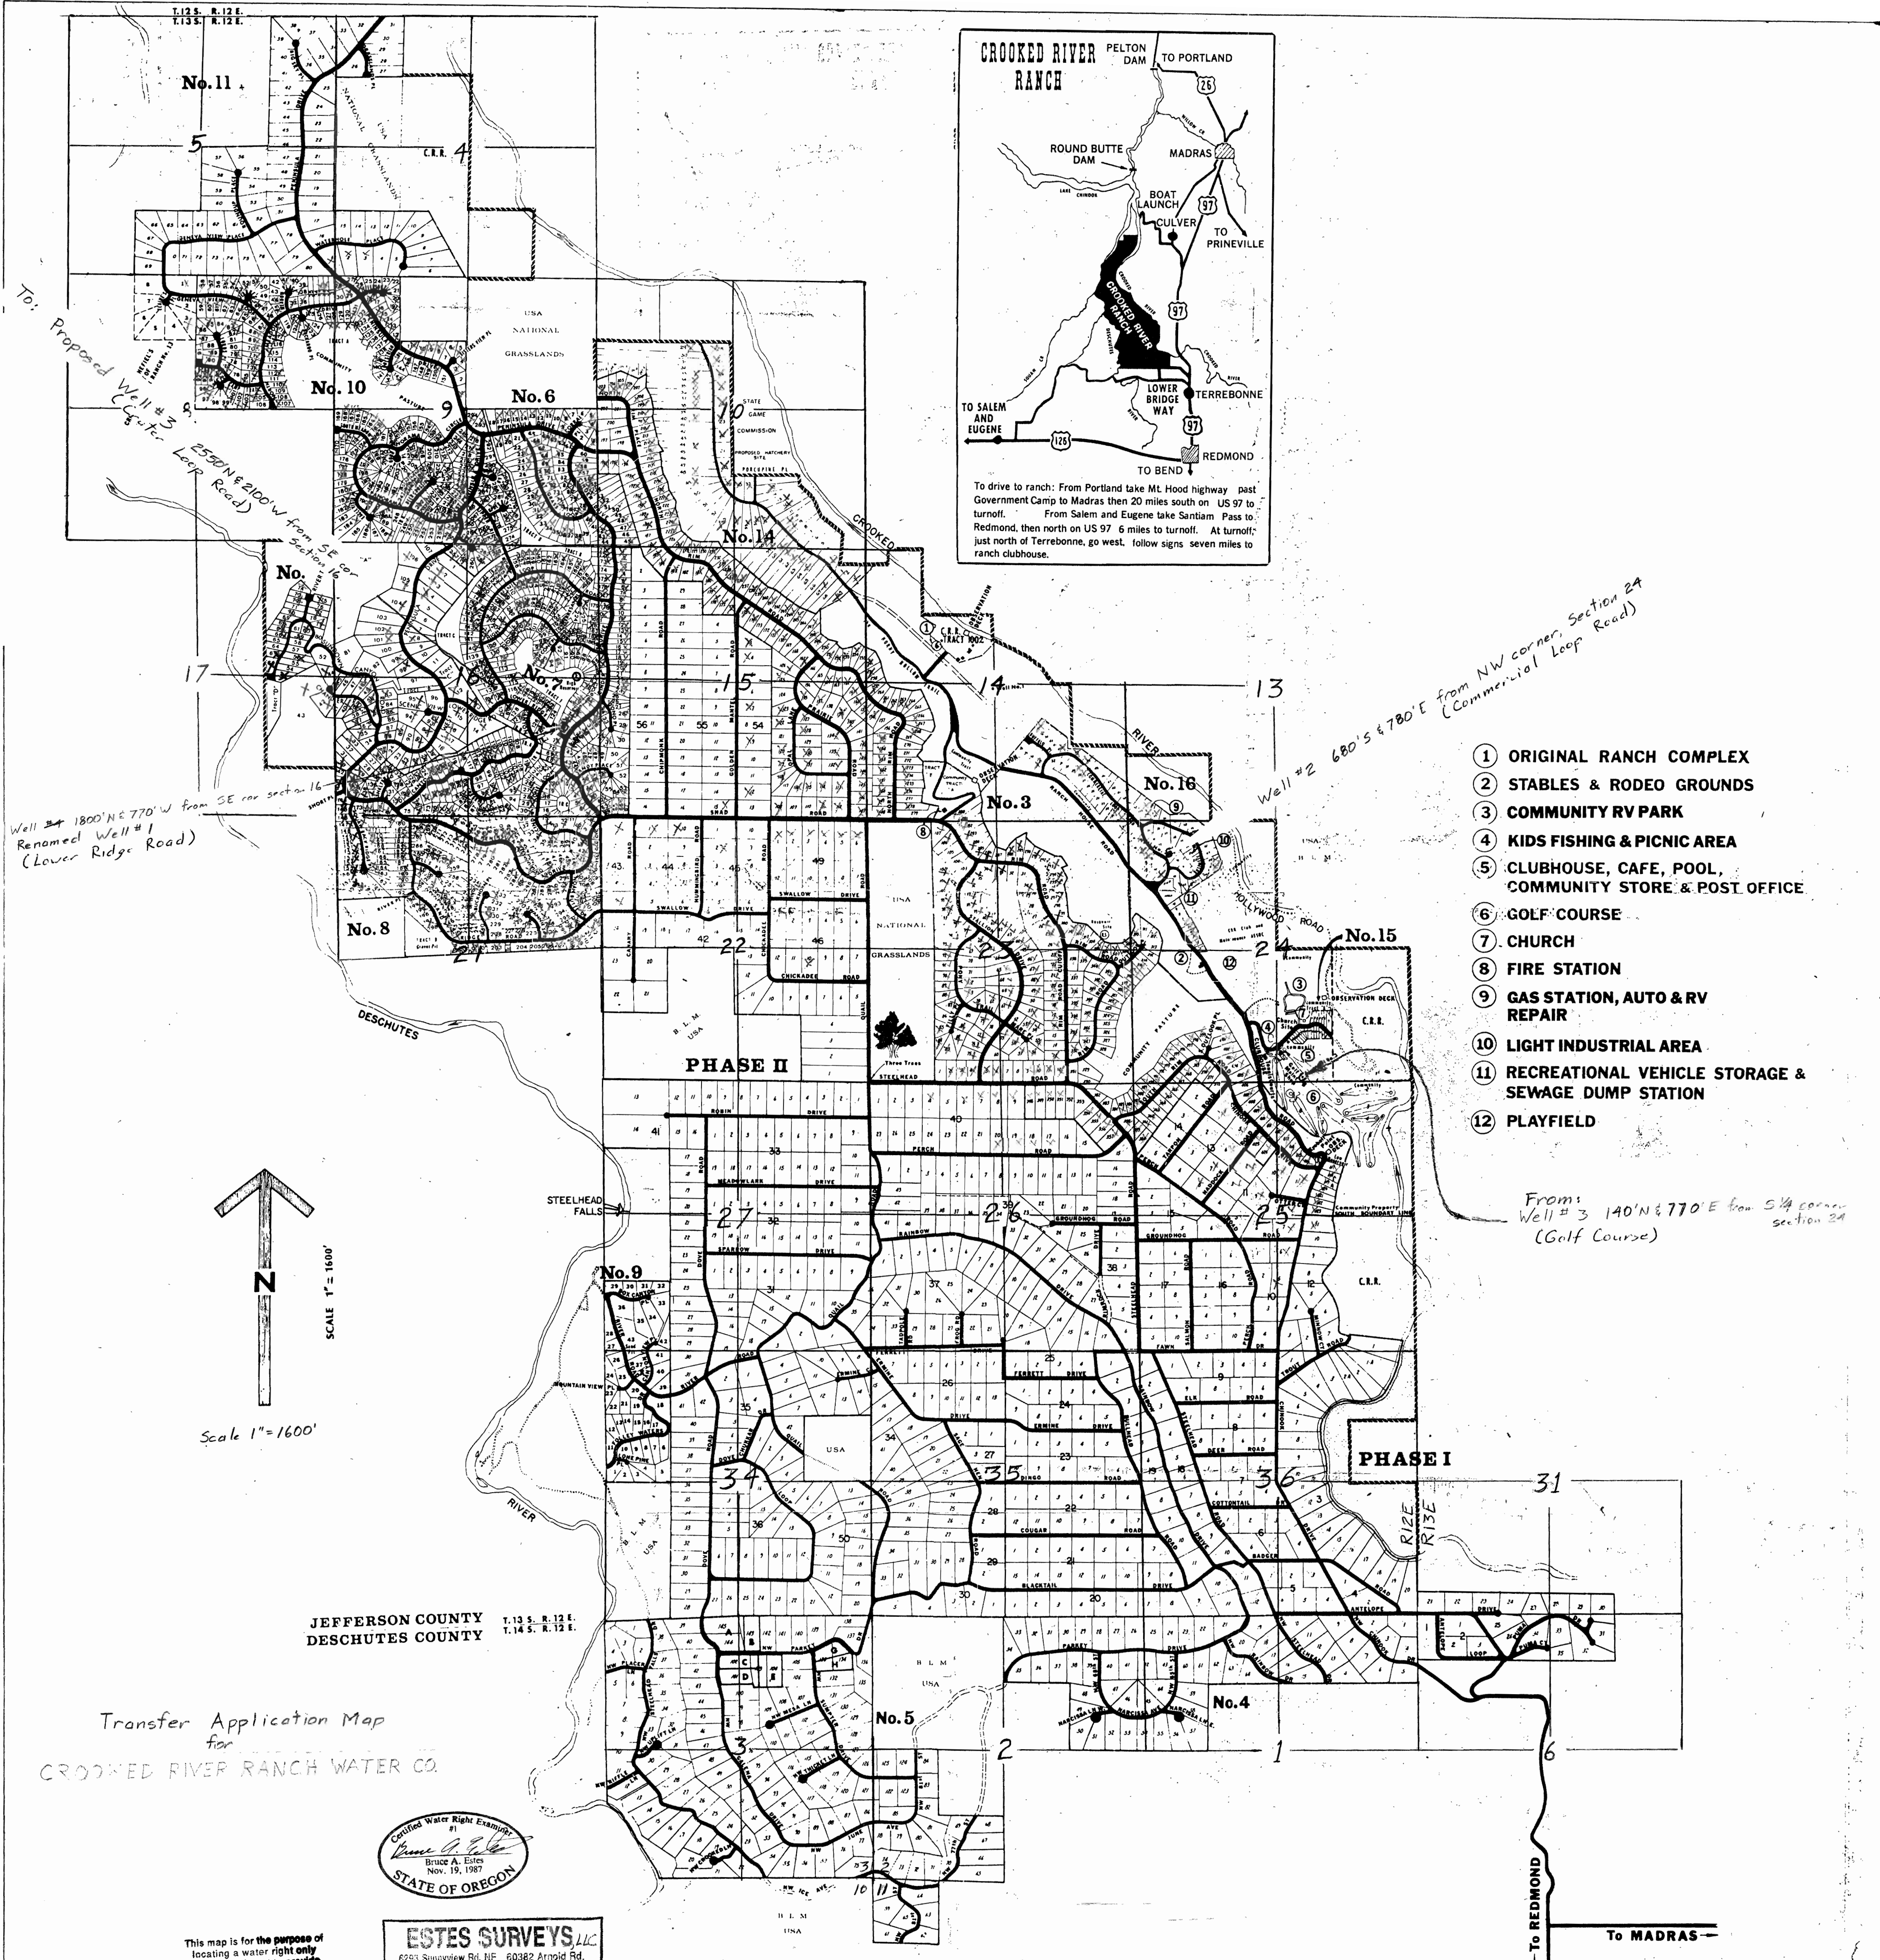

- ① ORIGINAL RANCH COMPLEX
- ② STABLES & RODEO GROUNDS
- ③ COMMUNITY RV PARK
- ④ KIDS FISHING & PICNIC AREA
- ⑤ CLUBHOUSE, CAFE, POOL, COMMUNITY STORE & POST OFFICE
- ⑥ GOLF COURSE
- ⑦ CHURCH
- ⑧ FIRE STATION
- ⑨ GAS STATION, AUTO & RV REPAIR
- ⑩ LIGHT INDUSTRIAL AREA
- ⑪ RECREATIONAL VEHICLE STORAGE & SEWAGE DUMP STATION
- ⑫ PLAYFIELD

From Well #3 140' N & 770' E from SW corner section 24 (Golf Course)

Certified Water Right Examiner
Bruce A. Estes
Nov. 19, 1987
STATE OF OREGON

ESTES SURVEYS, INC.
6250 Sunnyview Rd. NE
Salem, OR 97305
(503) 382-7391

This map is for the purpose of locating a water right only and has no intent to provide legal dimensions or the location