


City of Tigard
Water Right Transfer Application for Certificate No. 46638

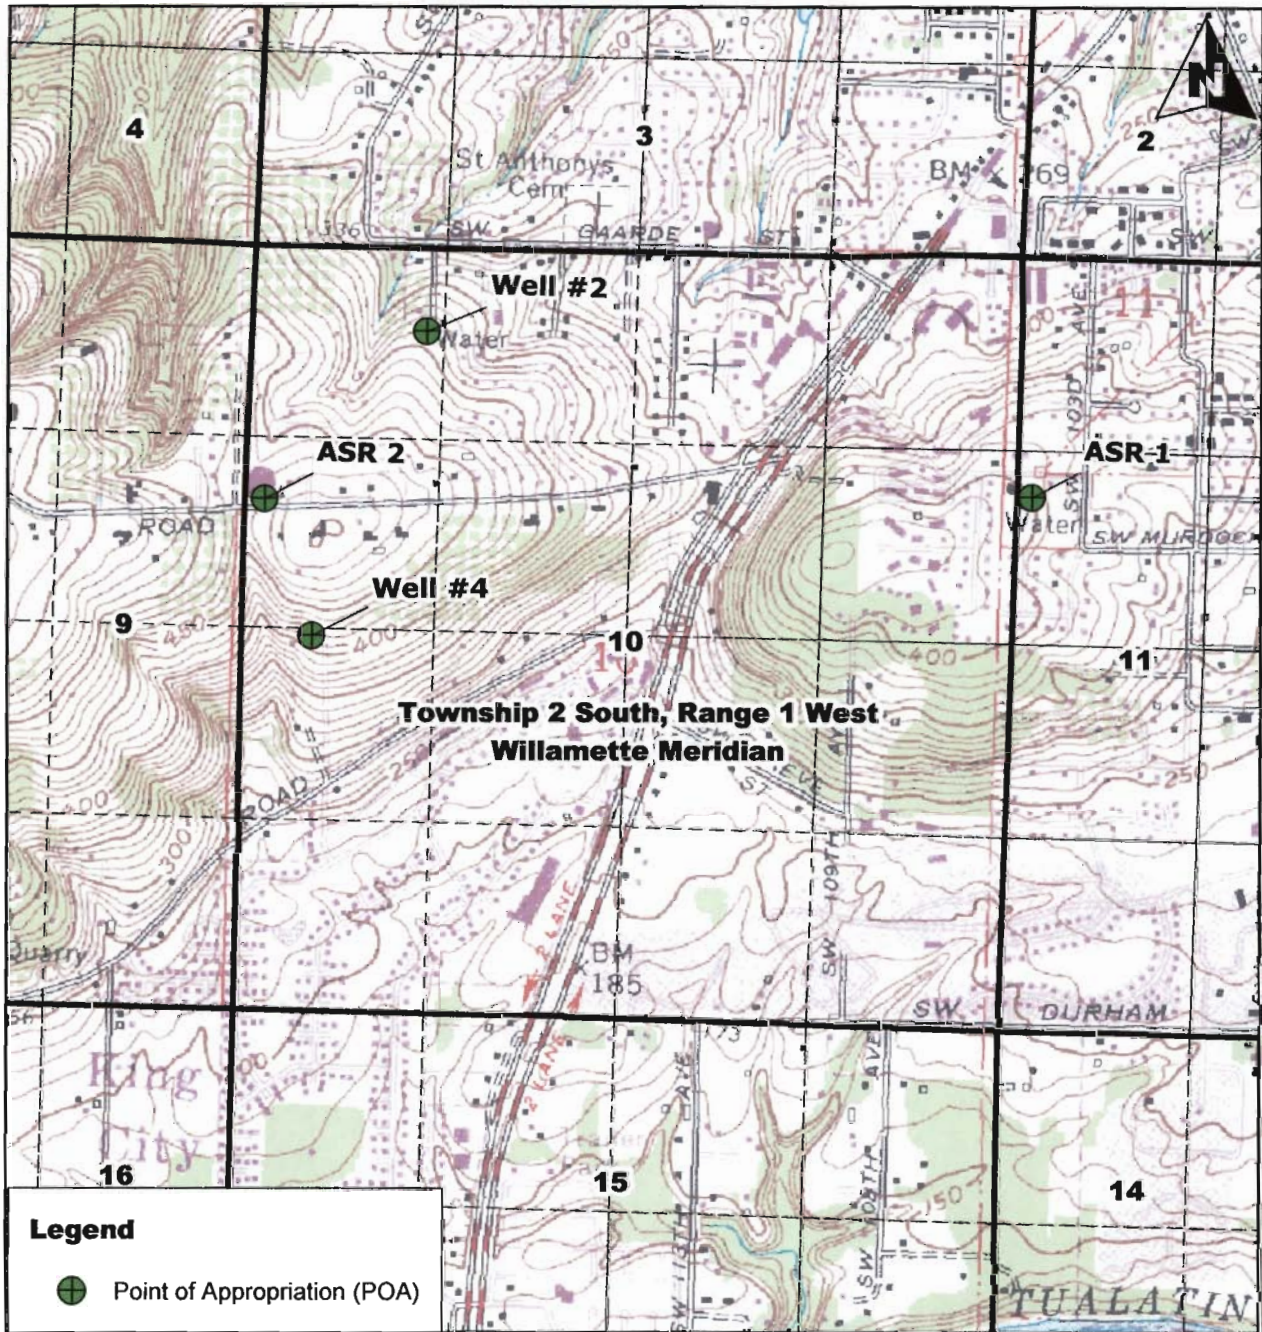

P:\103 - Tigard\GIS\cert46638_POAmap.mxd

POA Legal Description

Current POA

Well #4: Located 25 feet South and 500 feet East from the northwest corner of the southwest quarter of Section 10, Township 2 South, Range 1 West.

Additional POA Requested

ASR 2: Located 1,750 feet South and 100 feet East from the northwest corner of Section 10, Township 2 South, Range 1 West.

ASR 1: Located South 03° 13' 22" East and 1,561 feet from the northwest corner of Section 11, Township 2 South, Range 1 West.

Well #2: Located 610 feet South and 1,270 feet East from the northwest corner of Section 10, Township 2 South, Range 1 West.

Scale


1 inch equals 1,320 feet



This map was prepared for the purpose of identifying the location of a water right only and it is not intended to provide legal dimensions or location of property ownership lines.

Map Date: November 1, 2004

Prepared by: Groundwater Solutions, Inc.

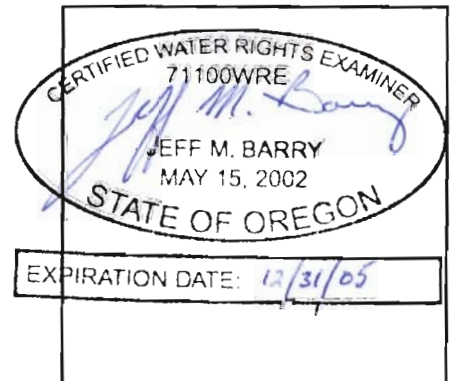

CWRE stamp and signature

T-9865

RECEIVED

FEB 16 2005