


TOWNSHIP 39 S, RANGE 20 E, W. M.

North

RECEIVED  
FEB 7 1934  
STATE ENGINEER  
SALEM, OREGON

West

East

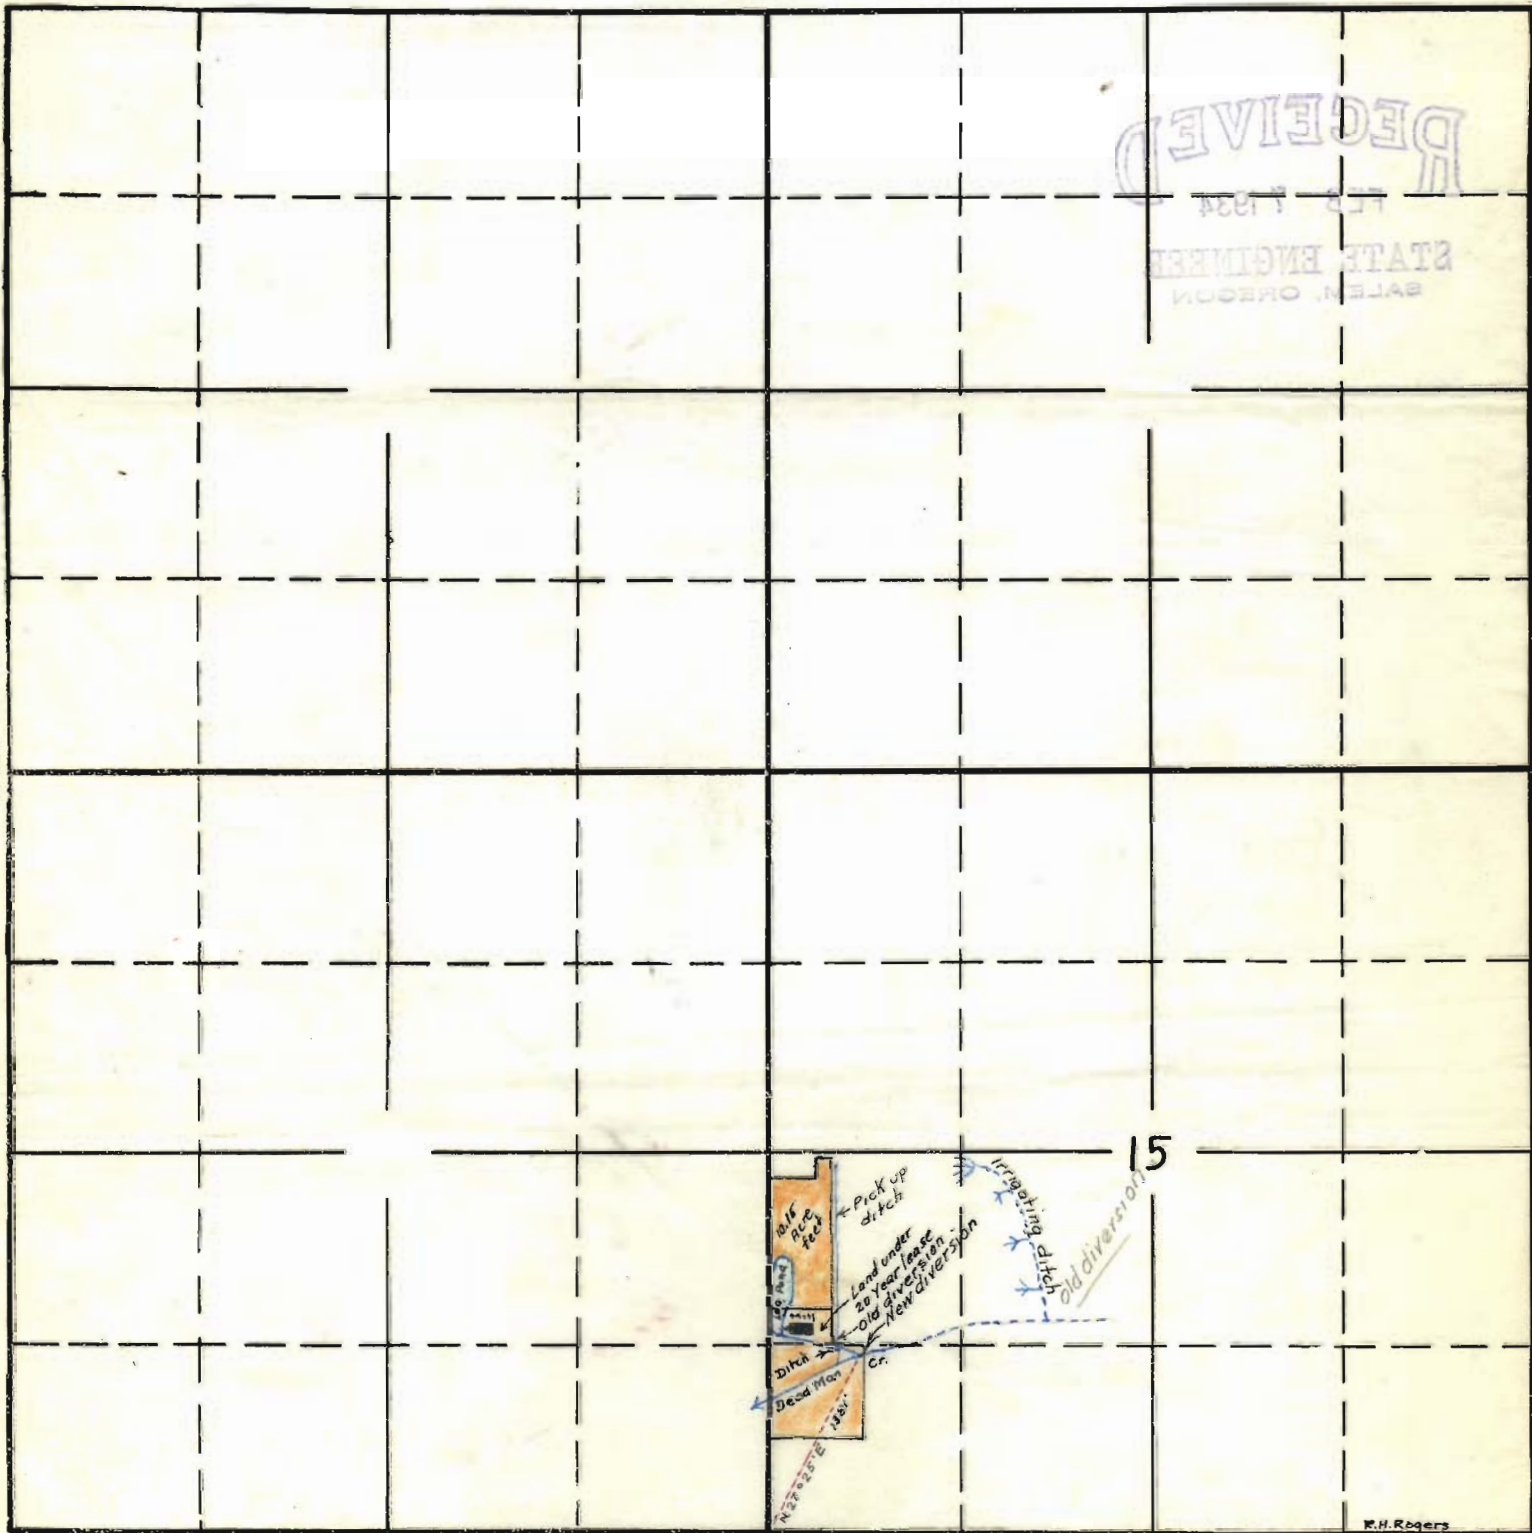

South

R.H. Rogers  
LaKeview, Oregon.

Transfer No. U-2

APPLICATION No.

PERMIT No.

540