


T.19S.R.47E.W.M.

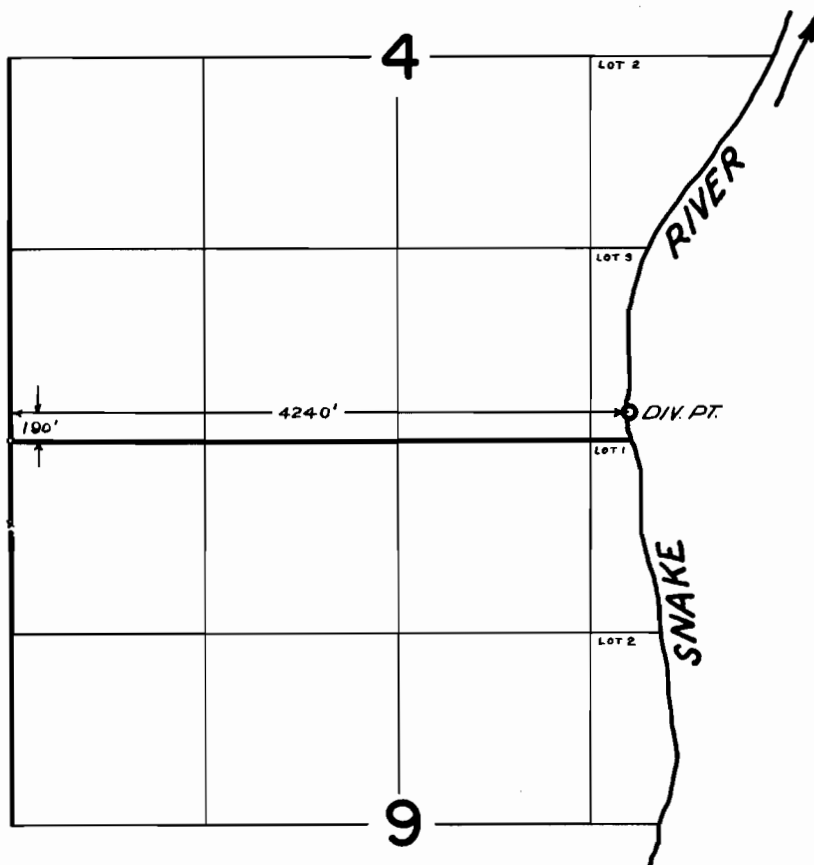

FINAL PROOF SURVEY
UNDER

Transfer U-II

Application No. _____ Permit No. _____

IN NAME OF

U. S. NATIONAL BANK

Surveyed Oct. 7 1965, by C. GARDNER