


T. 36 S. R. 4 W. W.M.

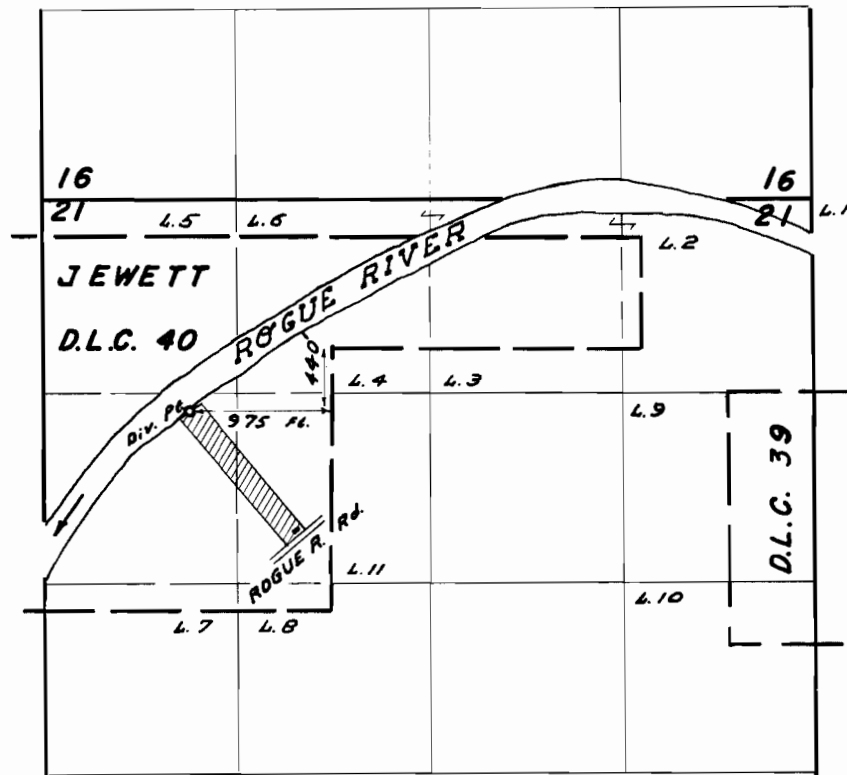

FINAL PROOF SURVEY
UNDER

TRANSFER V-19

Application No. _____ Permit No. _____

IN NAME OF

EARL VIVELL

Surveyed *JULY 19 1965*, by *L. COLEBANK*