
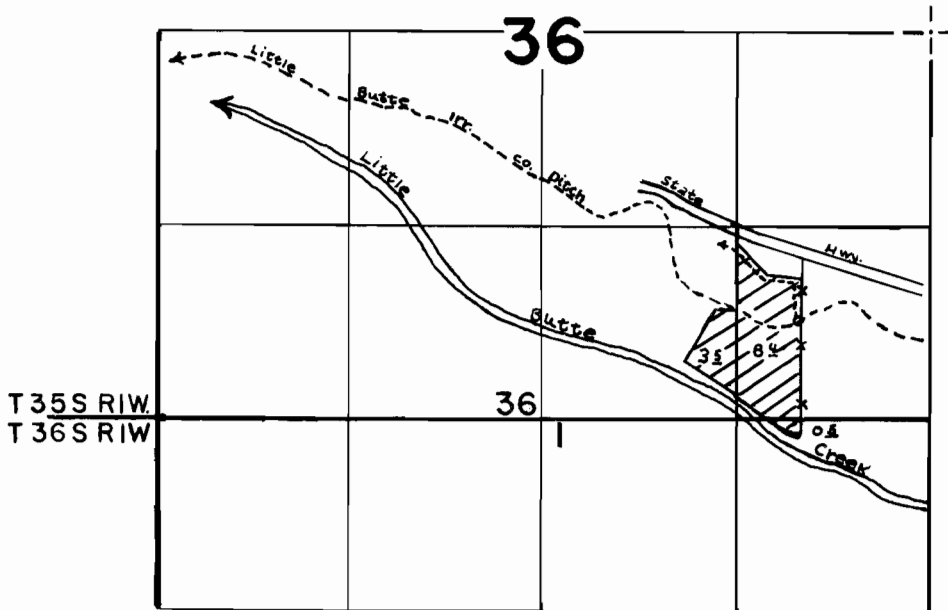


T 35 S RIW. W.M.

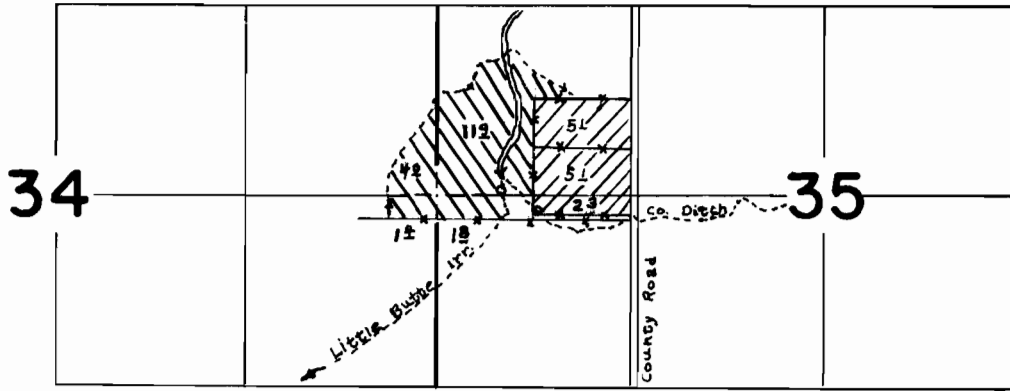

T 35 S RIW.
T 36 S RIW

-  WARRICK
-  STEVENS
-  KUNKEL

FINAL PROOF SURVEY UNDER

TRANSFER NO. V-27

Application No. Permit No.

IN NAME OF

WARRICK, STEVENS & KUNKEL

Surveyed JAN. 15, 1970, by D.C. HENDRIX

