


T. 7 S. R. 1 W. W. M.

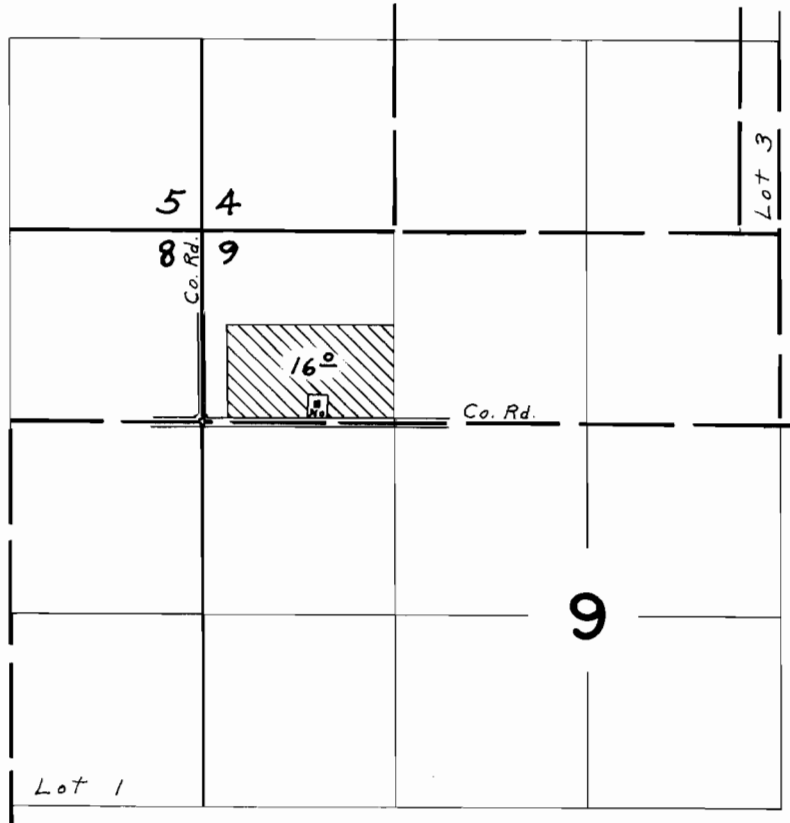

FINAL PROOF SURVEY
UNDER

Transfer V-28
Application No. Permit No.
IN NAME OF

WALTER VON FLUE

Surveyed *June 20, 1968*, by *L. E. Gould*