


T. 7S. R. 1W. W.M.

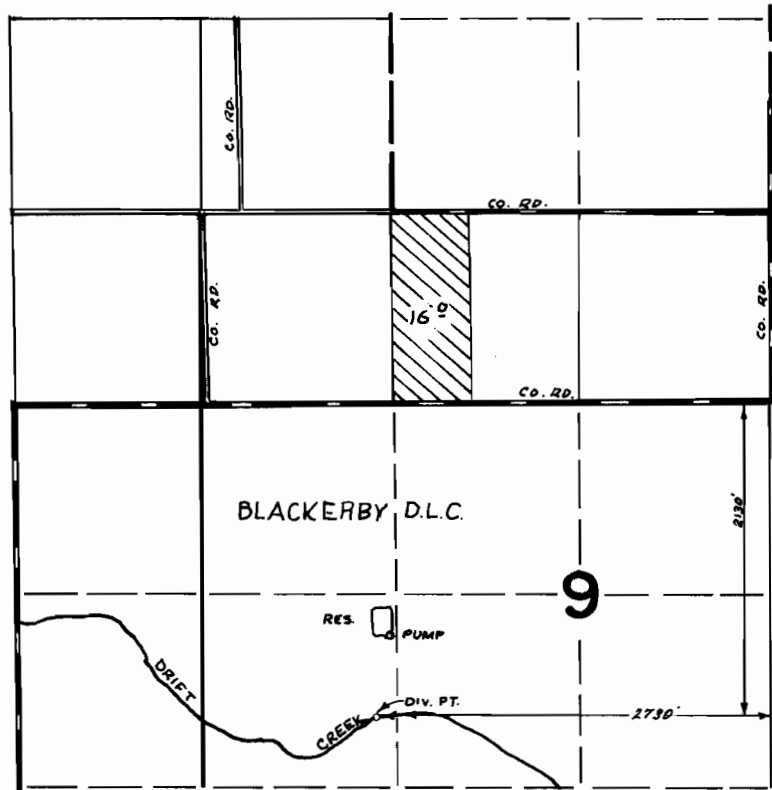

FINAL PROOF SURVEY UNDER

Transfer No. V-34

Application No. Permit No.

IN NAME OF

..... ALFRED VON FLUE

Surveyed APRIL 17, 1972, by D. NORBY