


T.7S.R.1W.W.M.

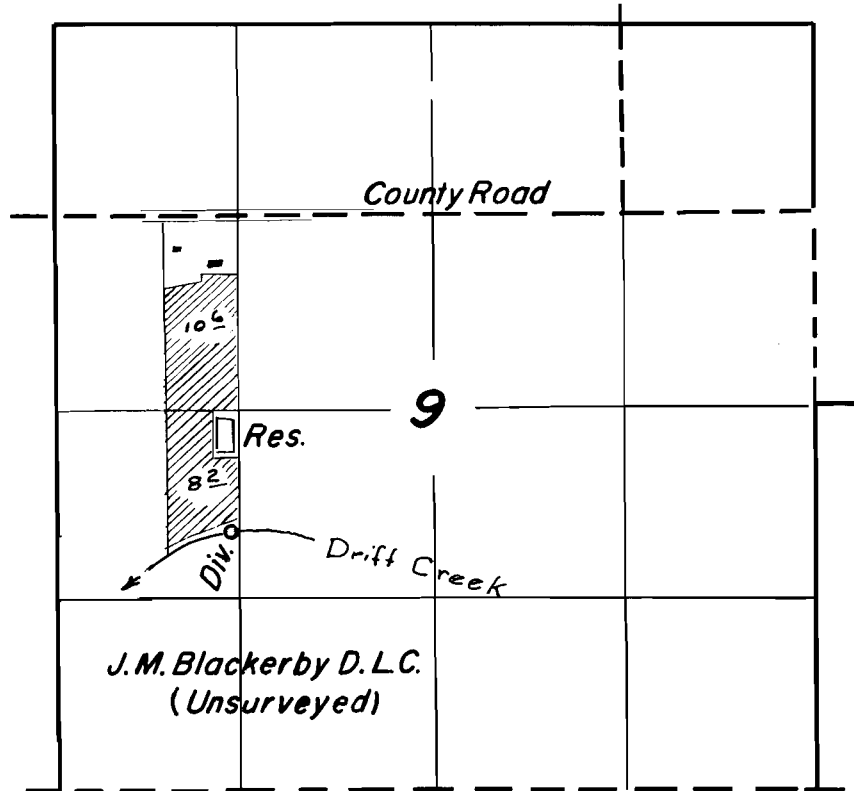

**FINAL PROOF SURVEY**  
UNDER

Transfer V-21  
R-37905 R 3091

Application No. 37906 Permit No. 28241  
IN NAME OF

**Alfred Von Flue**

Surveyed June 11, 1964, by *Floyd L. Sigmund*