


SECTION
27

TOWNSHIP 15, RANGE 43E, W. M.

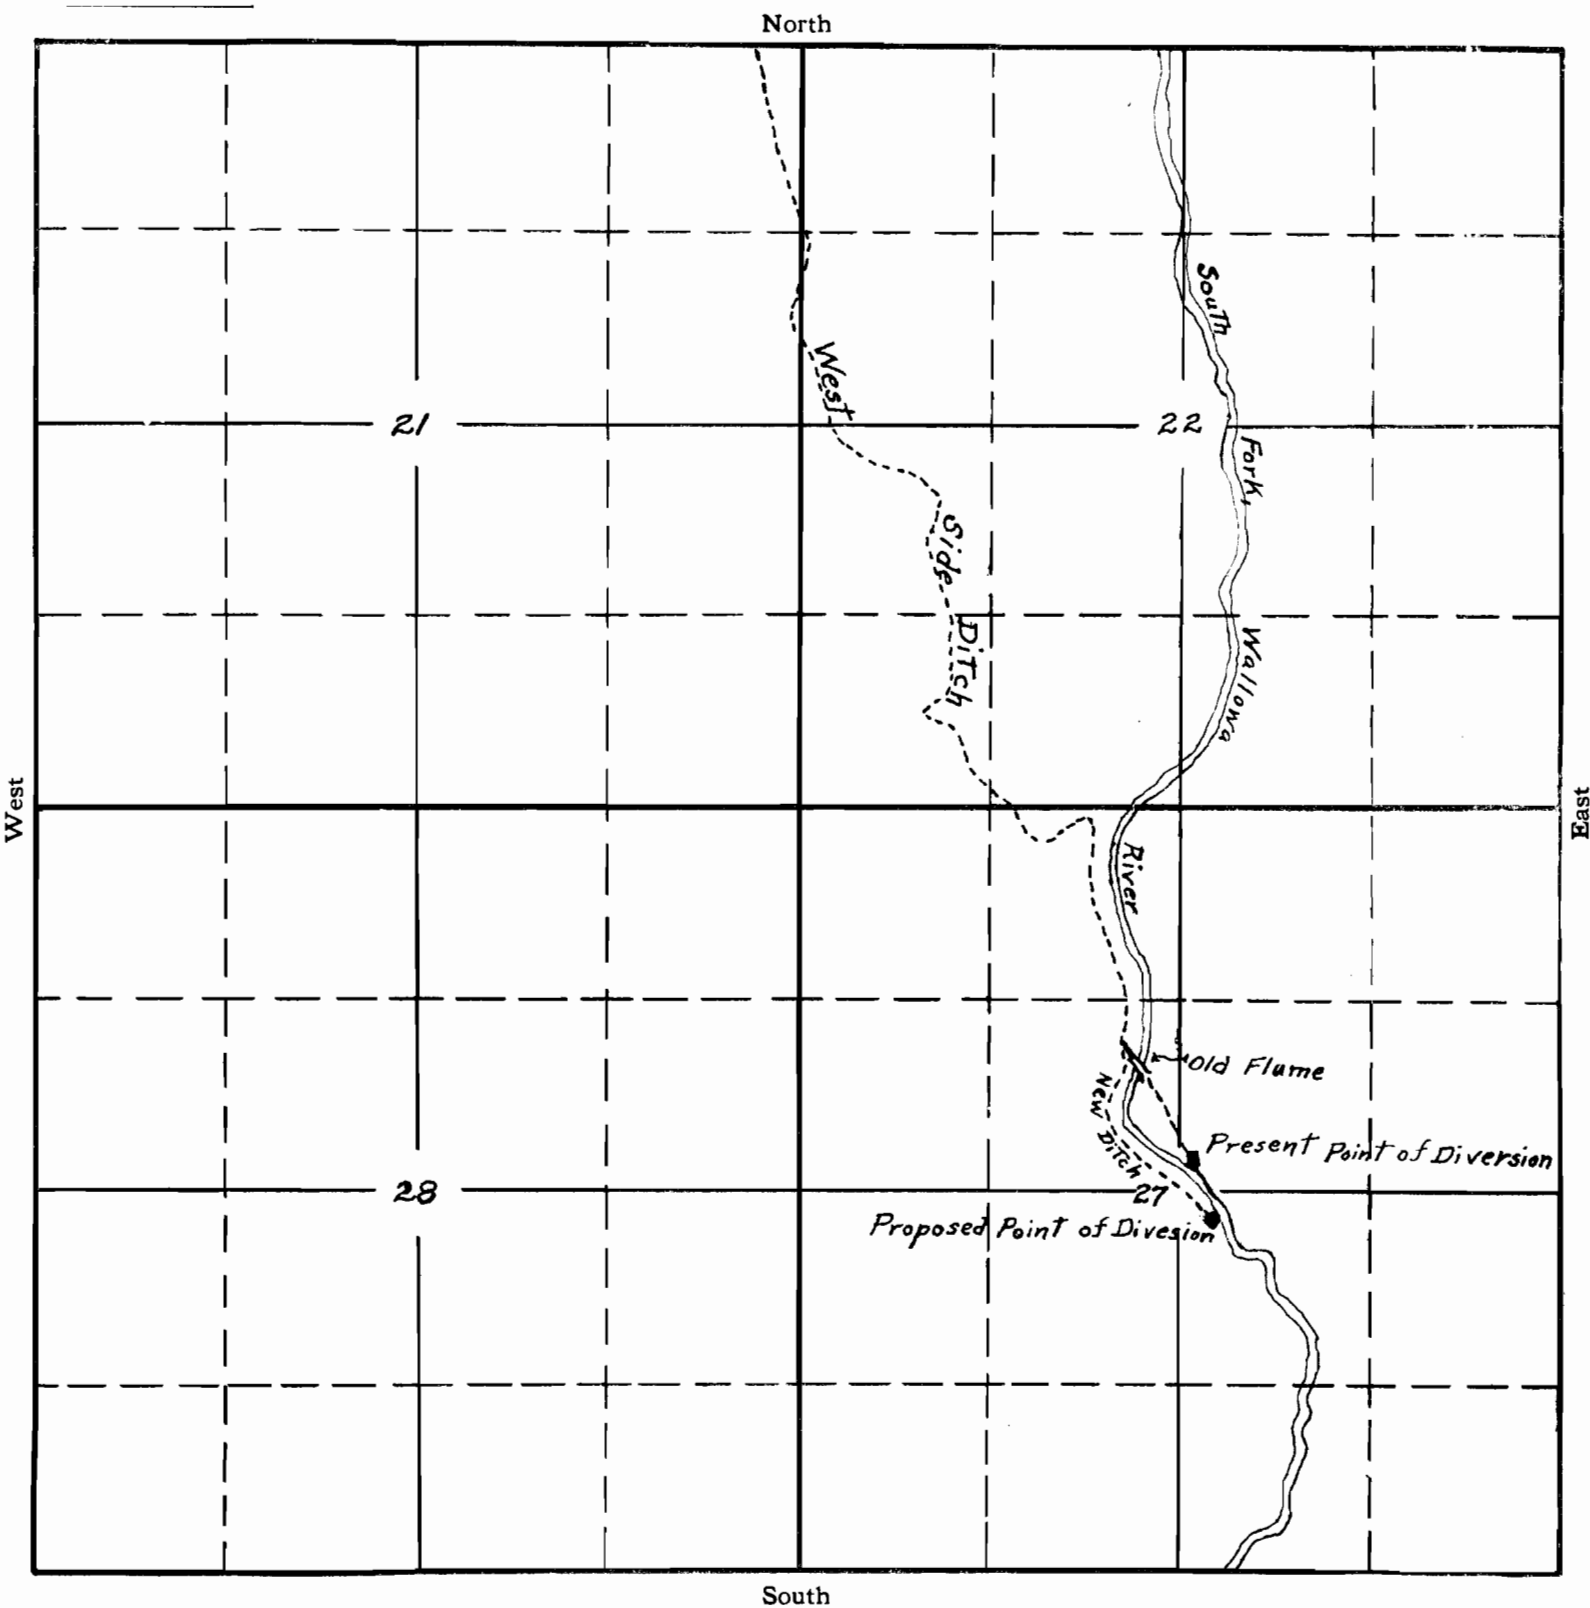

APPLICATION No.
PERMIT No.