


T2SR 11 E

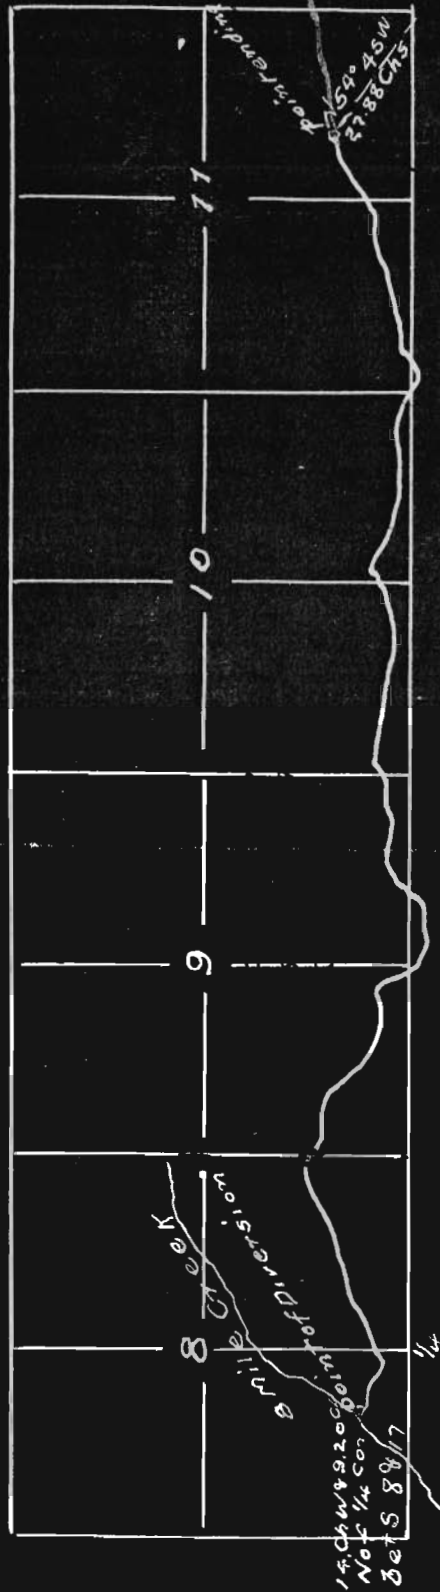

MAP OF

WOLF RUN WATER USERS ASSOCIATION DITCH

I A W Mohr do hereby certify that this map was made from notes taken during an actual survey made by me on June 5 in 1917 and that it correctly represents the works described in the accompanying application, together with the location of streams & other in the immediate vicinity. It is written thereon the smallest legal subdivision proposed to be irrigated

A W Mohr
Surveyor