


SECTION

21

TOWNSHIP 34S, RANGE 1W, W. M.

North

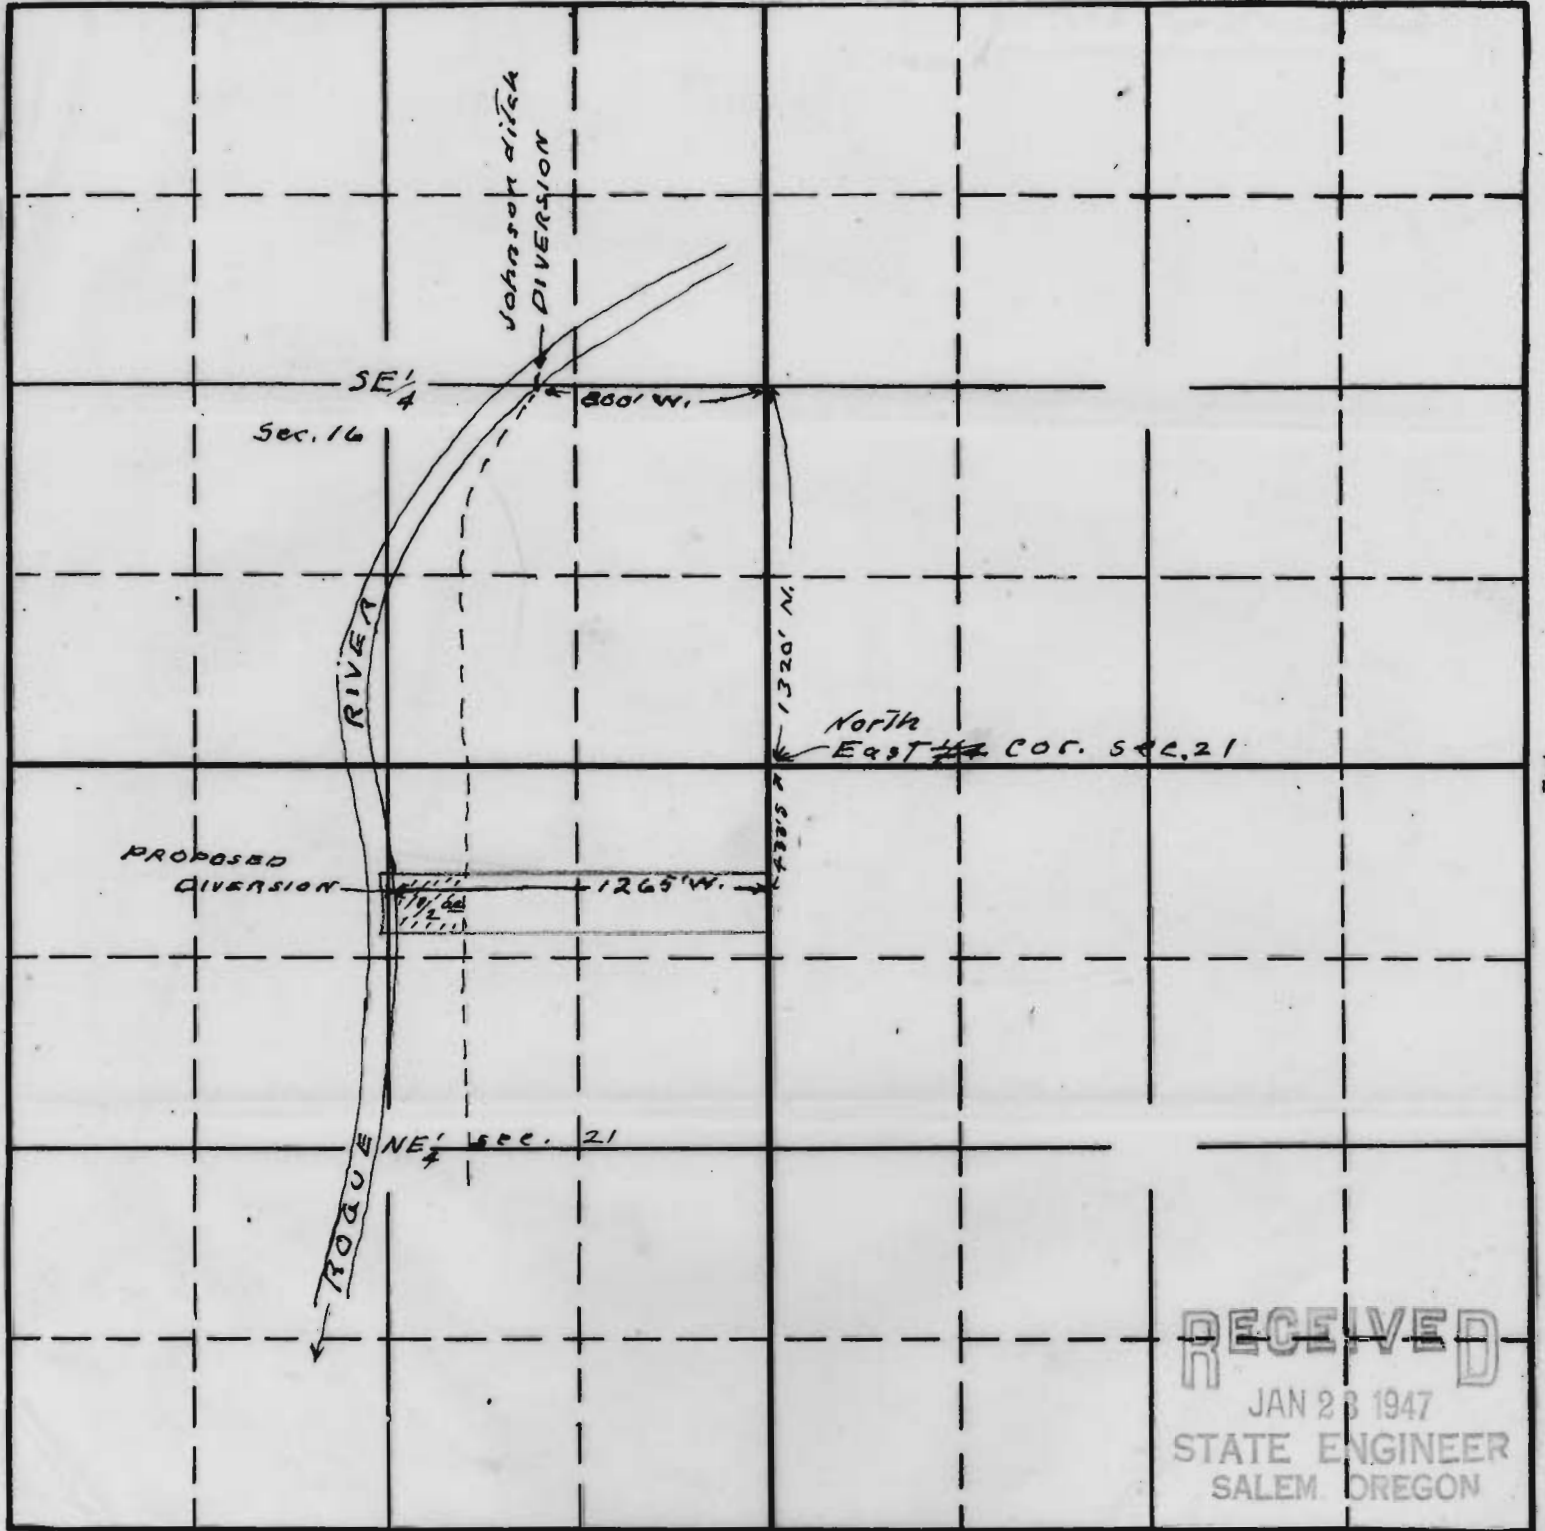

Map To accompany application of John G Watson for change in point of diversion

APPLICATION No.
PERMIT No.
W-34

This office 1/20/47