


T. 5 S. R. 13 E. W.M.

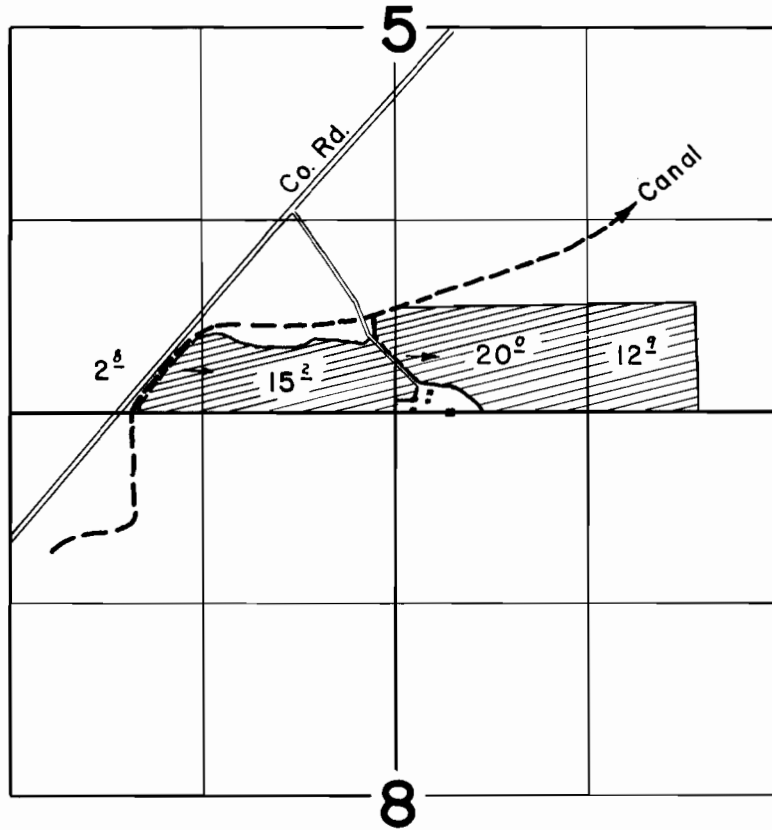

**FINAL PROOF SURVEY**  
UNDER

Transfer No. W-46  
IN NAME OF

LESTER CRABTREE

Surveyed June 2, 1964, by *L.W. Jelousik*