


T. 4 S. R. 13 E. W.M.

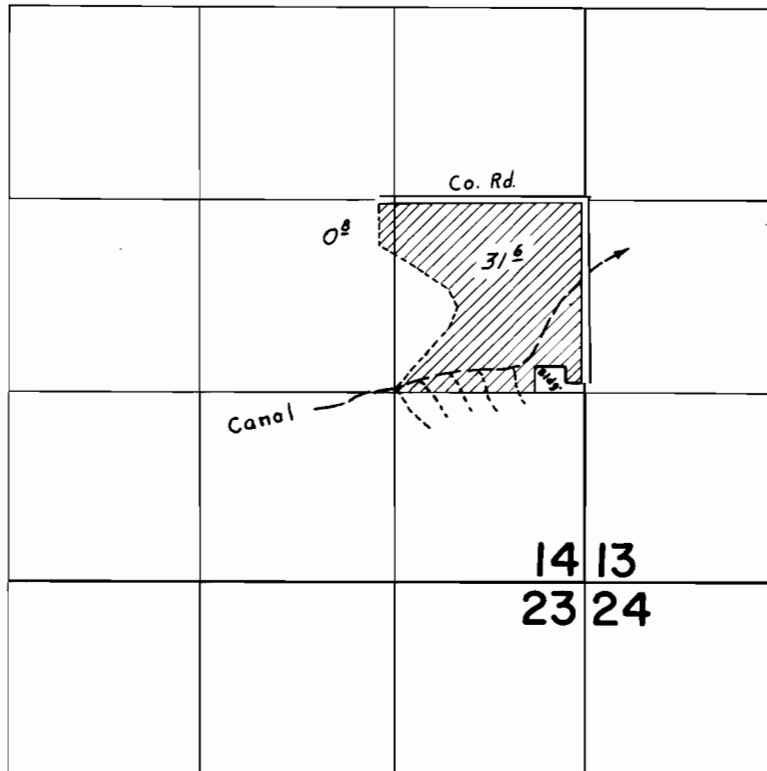

FINAL PROOF SURVEY
UNDER

Transfer No. W-59
IN NAME OF

RAYMOND CRABTREE

Surveyed *June 10* 19 *64*, by *L. W. Schuch*