


T.40S. R.23-24E.W.M.

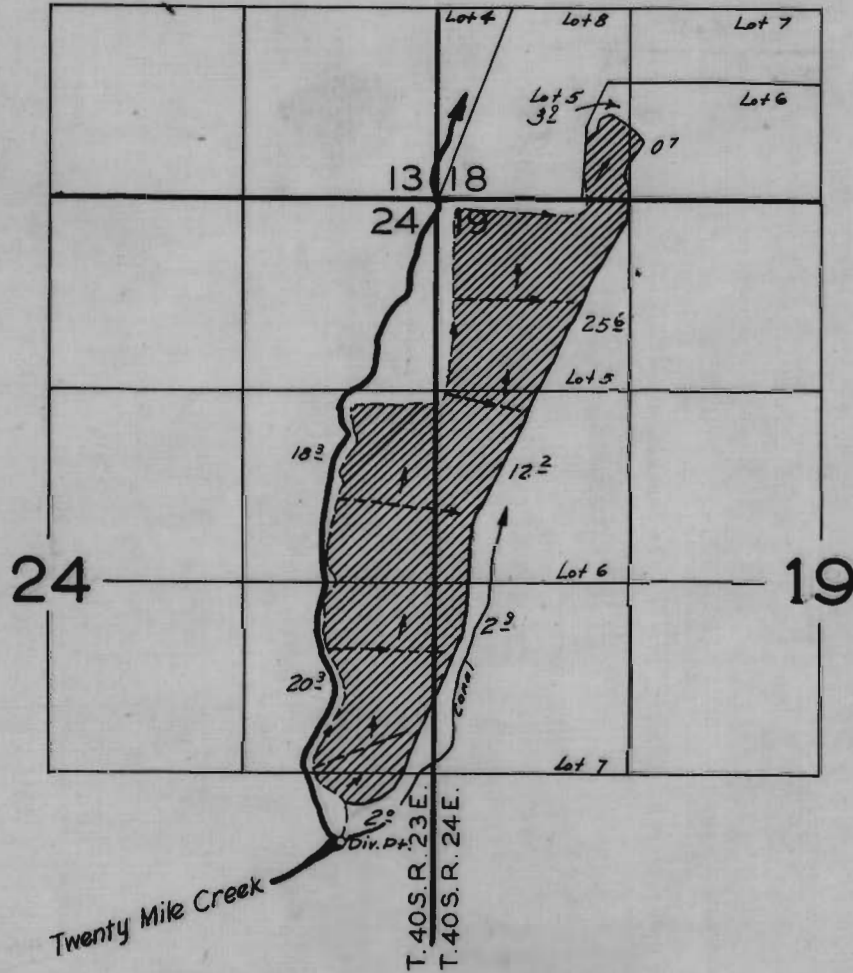

FINAL PROOF SURVEY
UNDER

Transfer No. W-65
IN NAME OF

WARNER VALLEY STOCK CO.

Surveyed May 11, 1959, by R. Jackson

Resurveyed by
Geo. V. Naderman