


T. 1 S. R. 25 E. W. M.

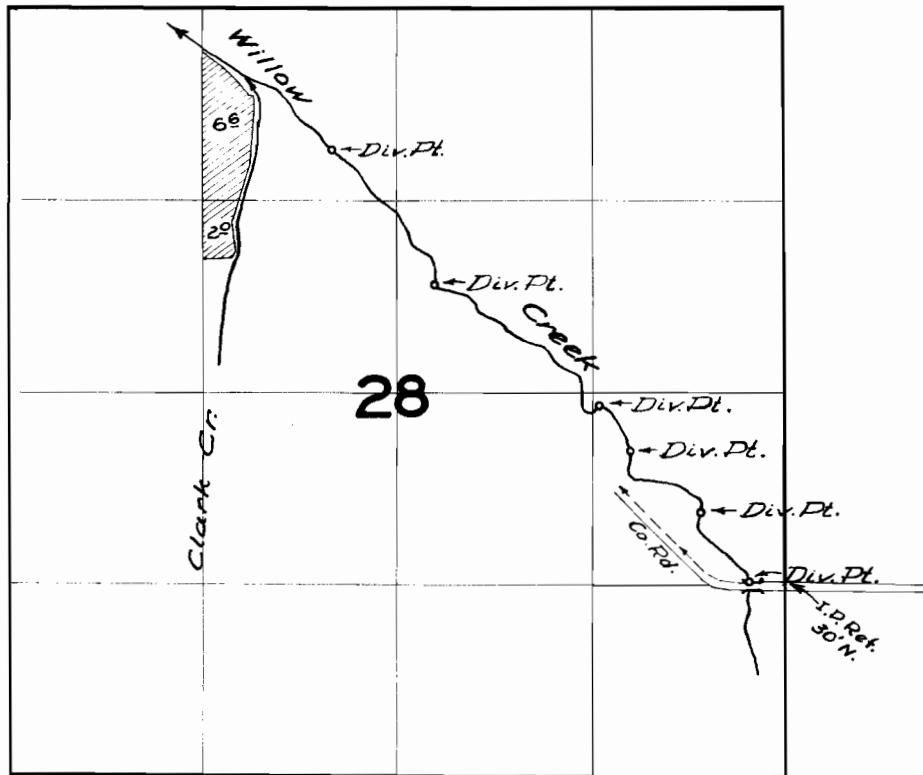

FINAL PROOF SURVEY UNDER

Transfer No. W-67

Application No. 2983.5 Permit No. 23464.
IN NAME OF

ALVIN E. WAGENBLAST

Surveyed 20 Oct. 1958, by *T. Bish*