


T. 14S. R. 14E. W.M.

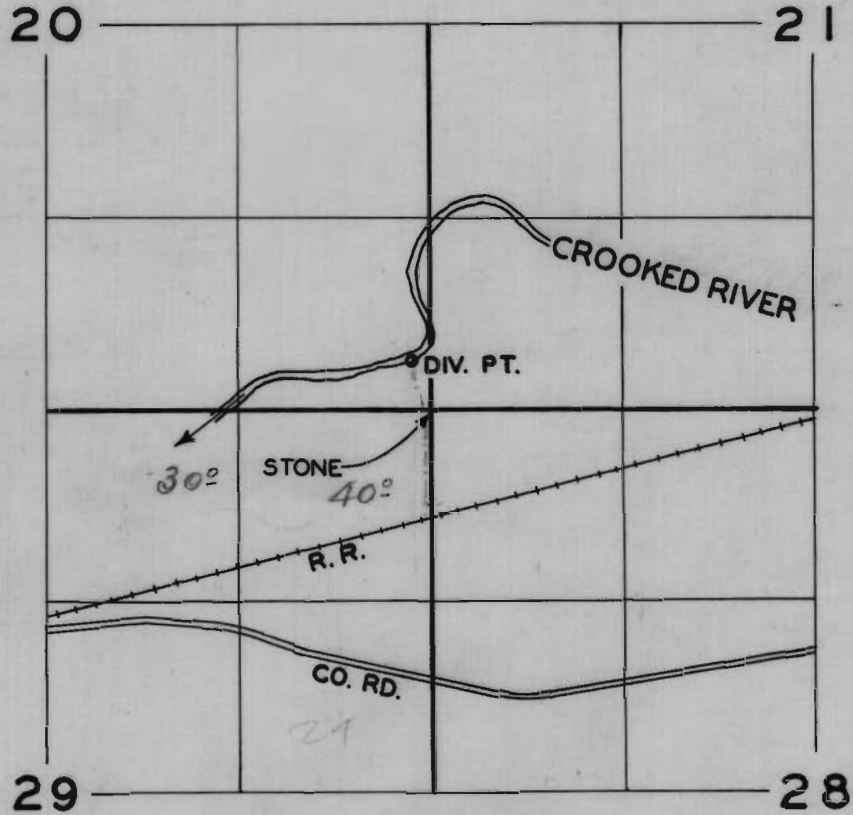

**FINAL PROOF SURVEY**  
UNDER

Application TRANSFER NO. W-78 No. \_\_\_\_\_  
IN NAME OF

**BERT WINTERS**

Surveyed SEPT. 26, 1960, by M. BISH