


# T.36S. R.1 W.W.M.

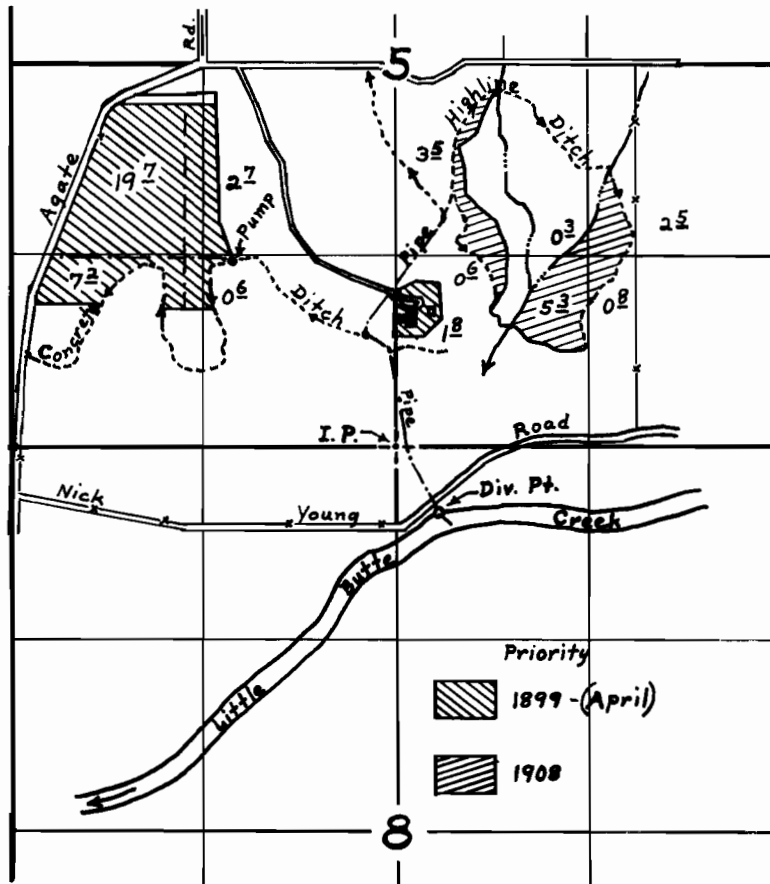

## FINAL PROOF SURVEY UNDER

Transfer No. W-82

Application No. \_\_\_\_\_ Permit No. \_\_\_\_\_  
IN NAME OF

John N. Winton

Surveyed April 30, 1963, by D.C. Hendrix