


T.14S.R.15E.W.M.

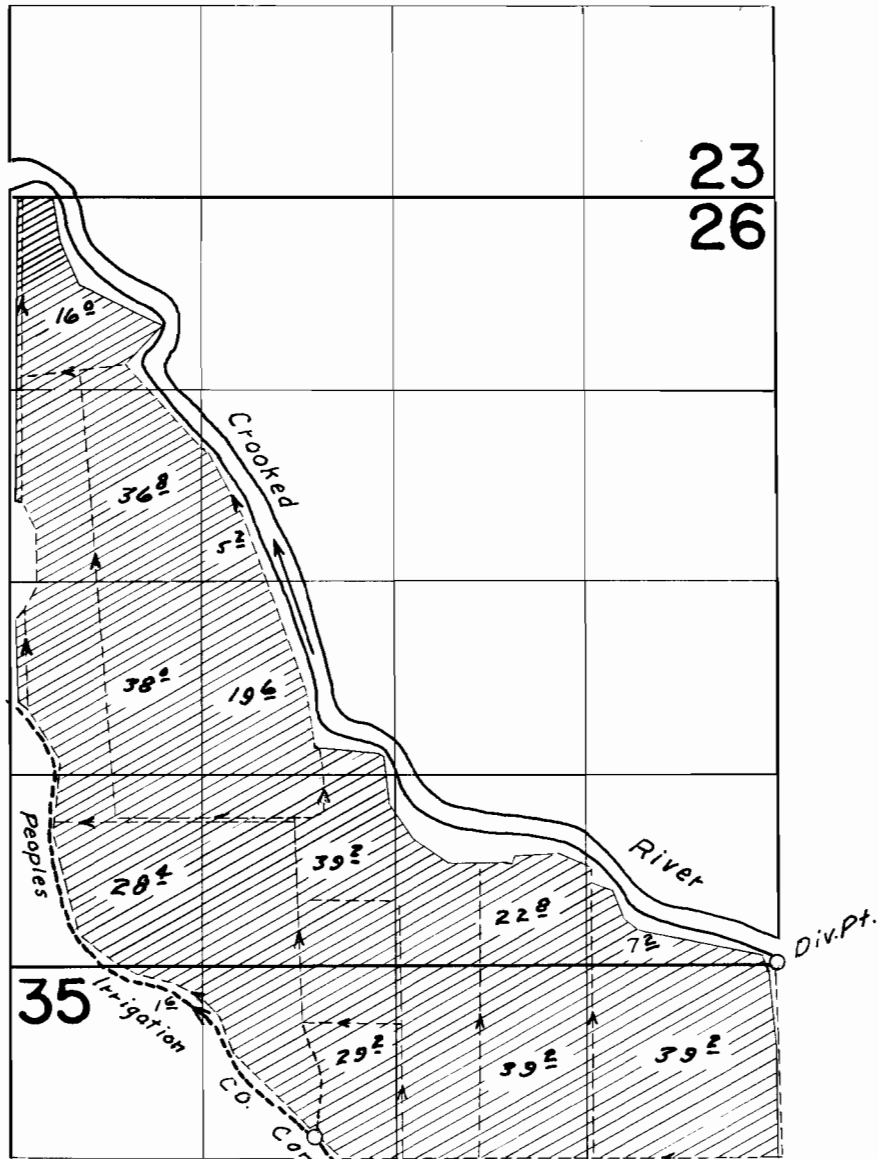

FINAL PROOF SURVEY
UNDER

Transfer No. W-86

Application No. Permit No.

IN NAME OF

CLAUDE P. WILLIAMS

Surveyed Sept. 29, 1964, by *C.J. Gardner*.....