



T. 1 N. R. 3 W. W. M.

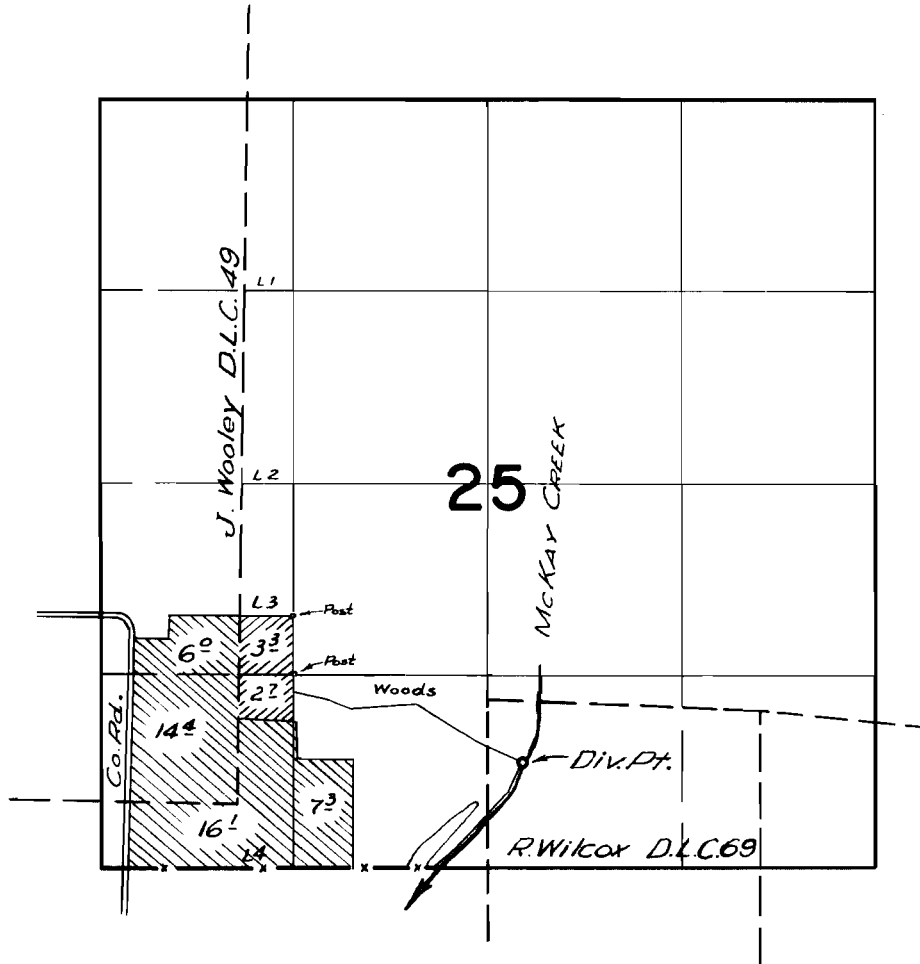

FINAL PROOF SURVEY UNDER

TRANSFER No. W-90 
Application No. 26063 Permit No. 20565
IN NAME OF

RAYMOND WAIBEL

Surveyed APRIL 2 1964, by 