


T.2N.R.13E.W.M.

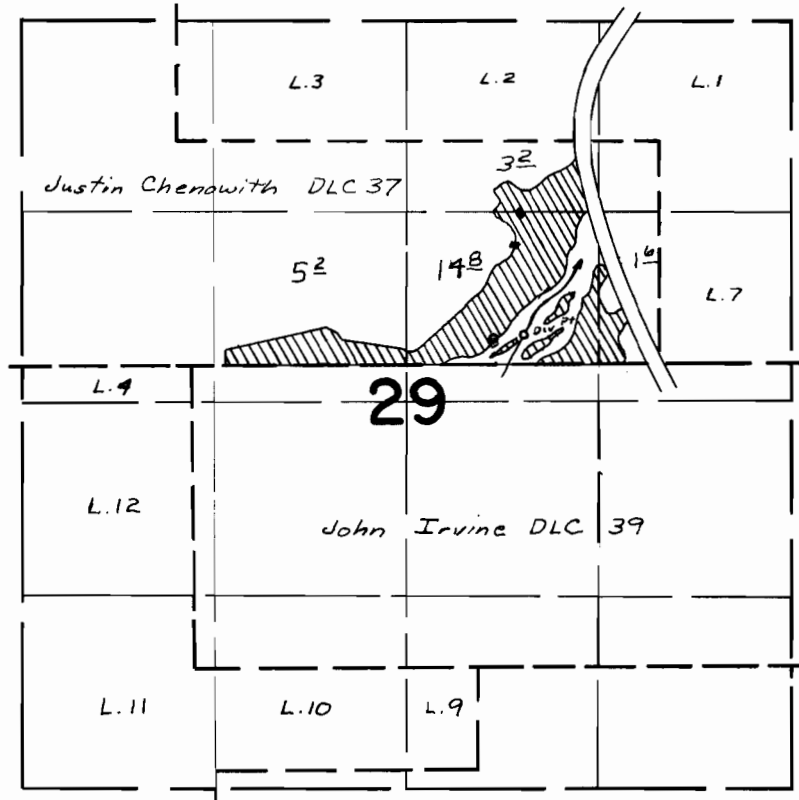

Div Pt located 200ft N + 990ft W from SE Cor DLC 37

FINAL PROOF SURVEY UNDER

Transfer No. W-100
Application No. _____ Permit No. _____
IN NAME OF

.....*Fred Wetle*.....

Surveyed *June 16, 1967*, by *W. S. Ruppert*.