


T.5S. R.3W.W.M.

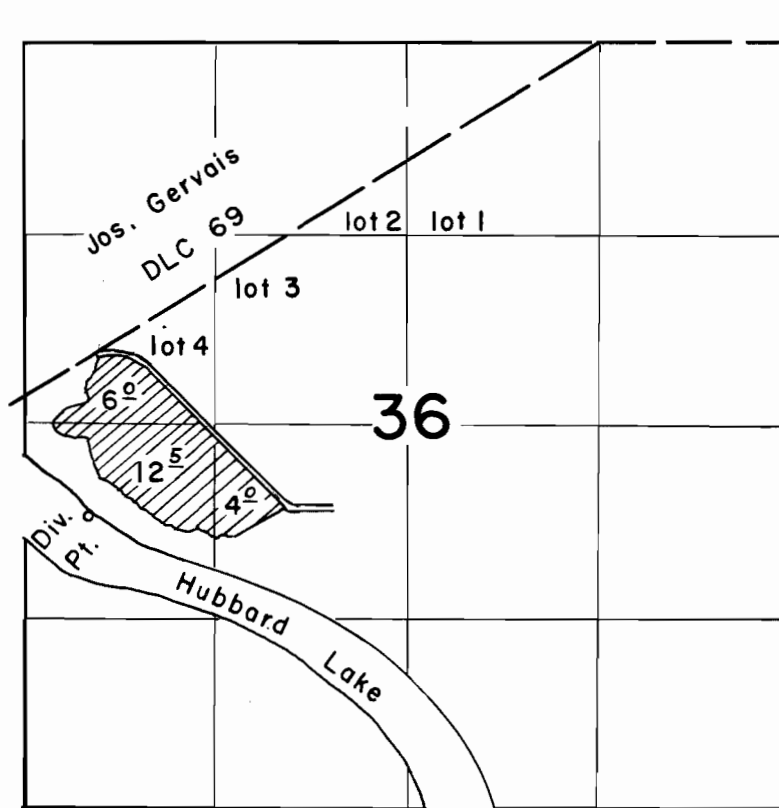

FINAL PROOF SURVEY UNDER

Transfer No. W102
Application No. _____ Permit No. _____
IN NAME OF

Earl & Hazel Weathers

Surveyed Oct. 5, 1964, by F. Siegmund