
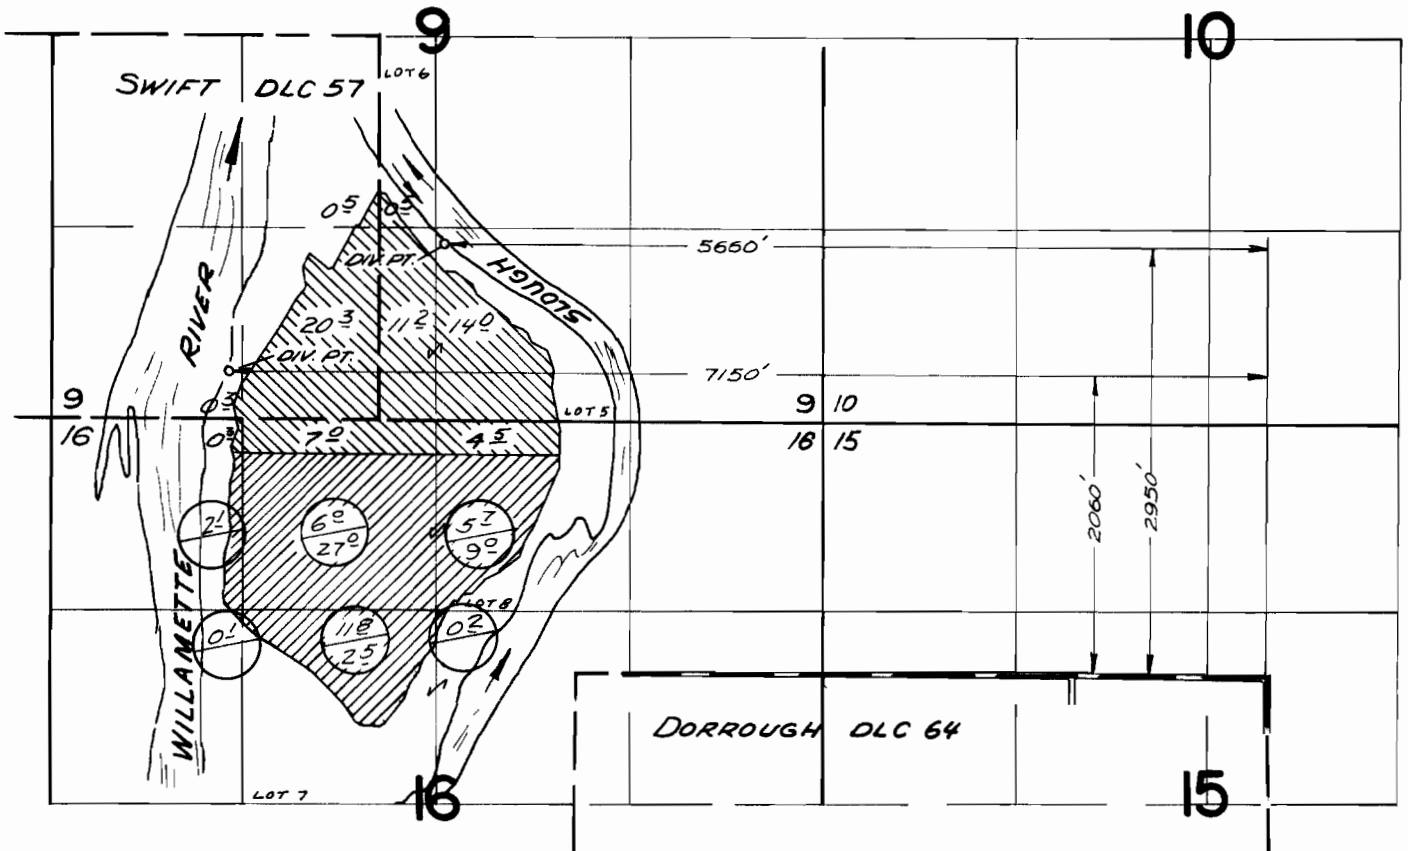



T. 6 S. R. 3 W. W.M.

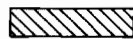

 PERMIT 29737
  TRANSFER W-106
 CERTIFICATE NO. 31728

FINAL PROOF SURVEY UNDER

TRANSFER W-106

Application No. 39956. Permit No. 29737.
IN NAME OF

WHITLAICH - STUART and SONS, INC.

Surveyed June 18 1965, by R. JACKSON
April 8 1968 by V. GARNER