


T. 1 N. R. 39 E. W.M.

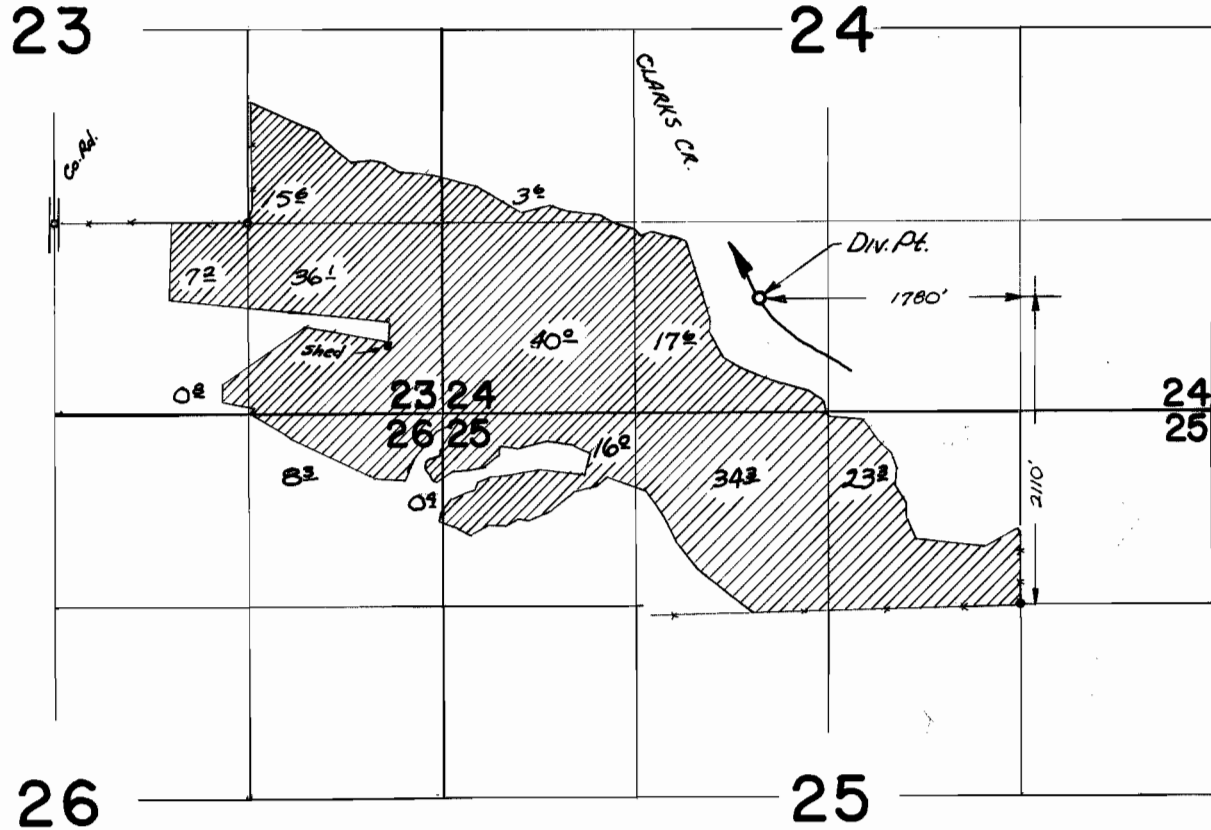

FINAL PROOF SURVEY UNDER

TRANSFER W 114
Application No. 41782... Permit No. 31186...
IN NAME OF

PETER C. WESTENSKOW

Surveyed 28 AUG. 1969, by W. J. RUPPERT