


T. 15 S. R. 10 E. W. M.

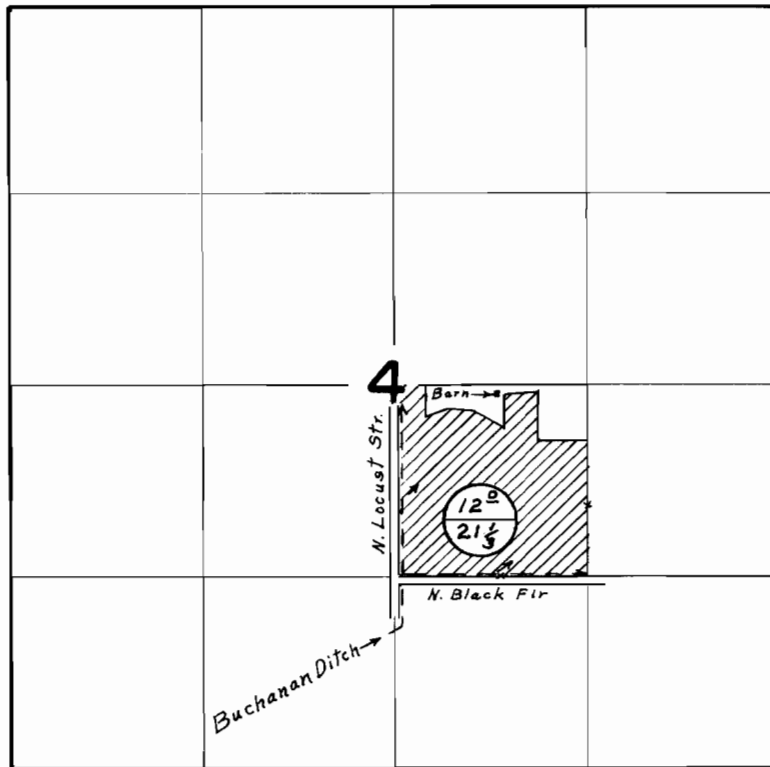

CERT. NO. 429  
TRANS. NO. W-116



**FINAL PROOF SURVEY**  
UNDER

TRANSFER NO. W-116  
Application No. .... Permit No. ....  
IN NAME OF  
**PETE F. LEITHAUSER**

Surveyed Oct. 24, 1968, by W. J. Ruppert