


T.19S. R.1W. W. M.

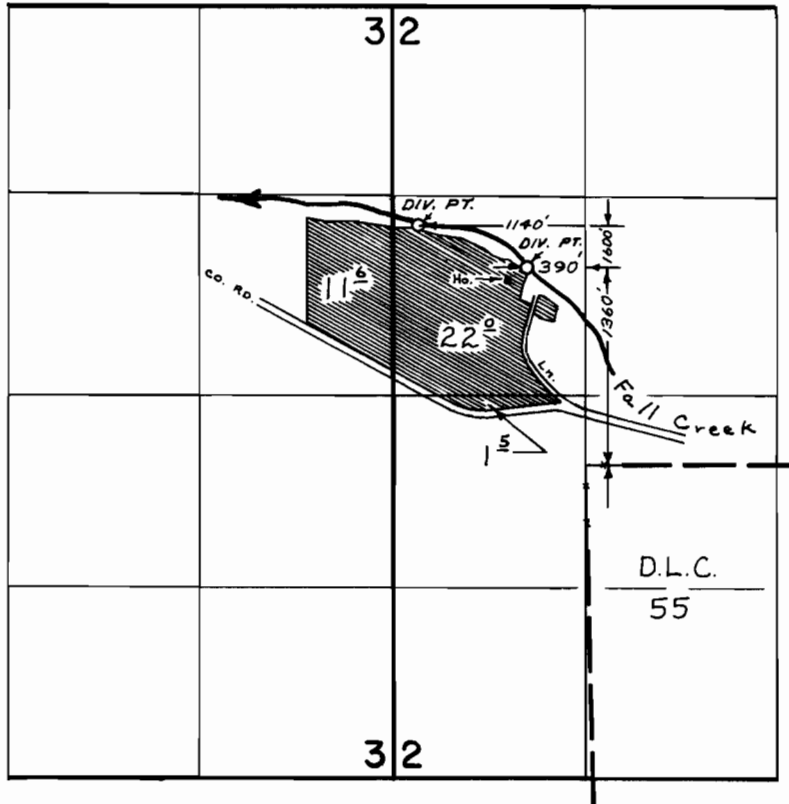

FINAL PROOF SURVEY
UNDER

Transfer No. W-117
Application No. Permit No.

IN NAME OF

JAMES R. WIEMERS

Surveyed April 18, 1975, by R. Mucken