


T.17S., R.14E., W.M

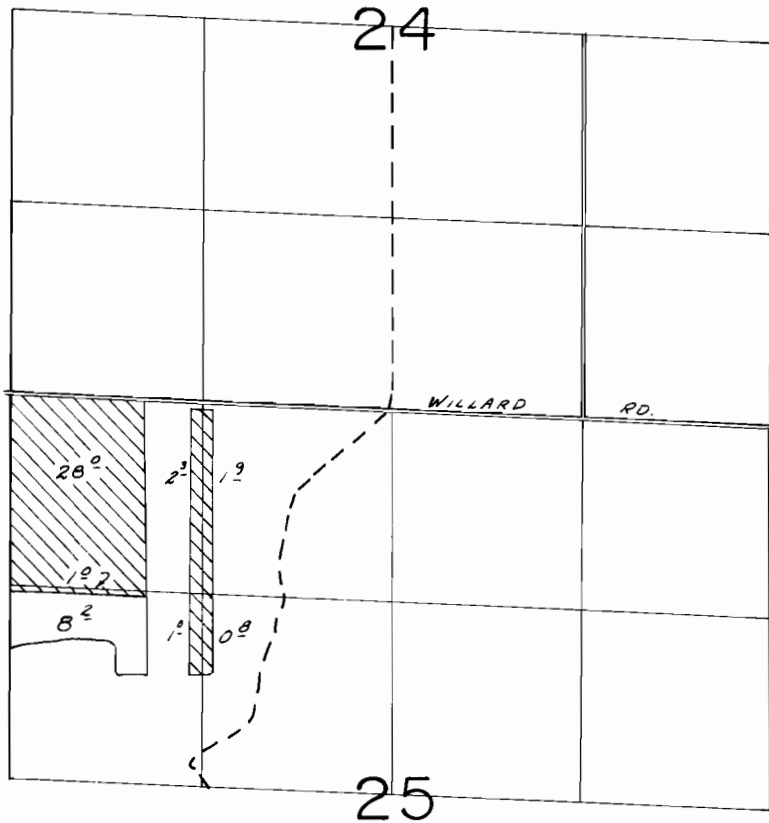

SCALE: 1"=1320'

FINAL PROOF SURVEY
UNDER

Transfer No. W-123

IN NAME OF

.....**DAVID HAASE & LEE RHOADS**.....

Surveyed July 23, 1984, by L.G. OLSON.....