


T. 36 S. R. 1 E. W. M.

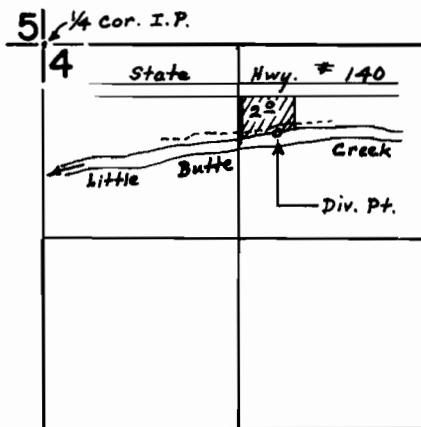

Div. pt. is 620' S & 1610' E from  
the W  $\frac{1}{4}$  cor. of sec. 4

**FINAL PROOF SURVEY**  
UNDER

**Trans.No. W-124**

Application No. \_\_\_\_\_ Permit No. \_\_\_\_\_

IN NAME OF

**R.A. & B.R. WIES**

Surveyed **Feb. 9 1971**, by **D.C. Hendrix**