


T.38S. R.3W. W.M.

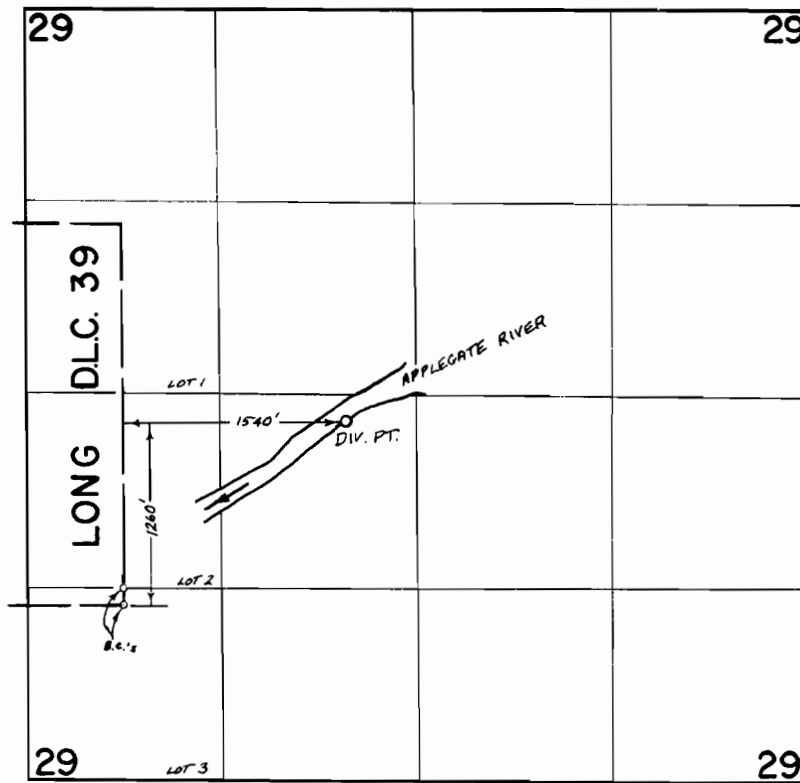

FINAL PROOF SURVEY UNDER

Application No. _____ TRANSFER NO. W-126
Permit No. _____
IN NAME OF

..... EDWIN D. JONES

Surveyed AUG. 12 1975, by L. TOLL