


T. 7 S. R. 4 E. W. M.

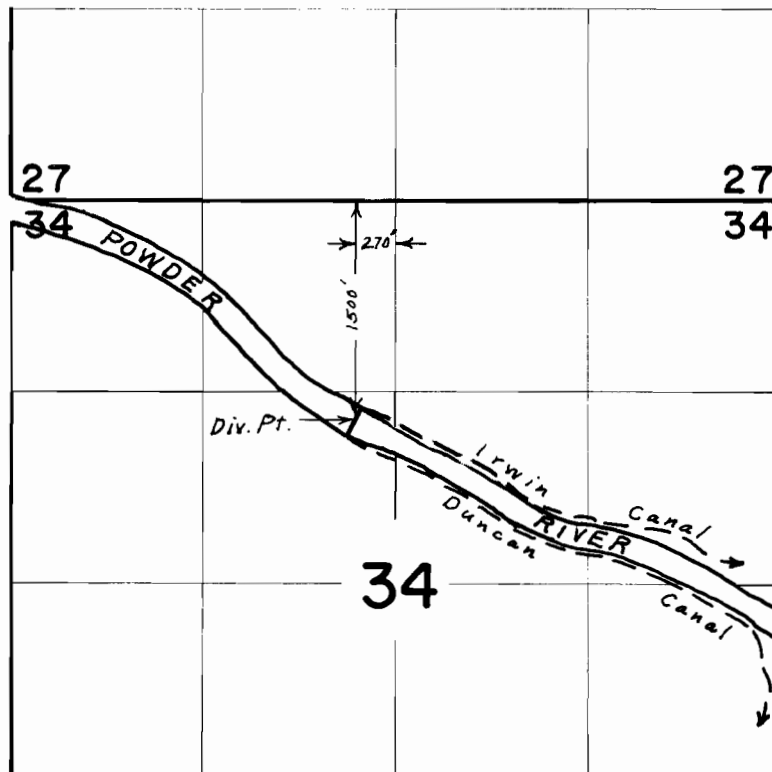

FINAL PROOF SURVEY
UNDER

Application No. _____ TRANSFER W-127
Permit No. _____
IN NAME OF

JACK D. WELLINGTON

Surveyed May 13, 1970, by L. E. Gould