


T. 1 S., R. 32 E., W.M.

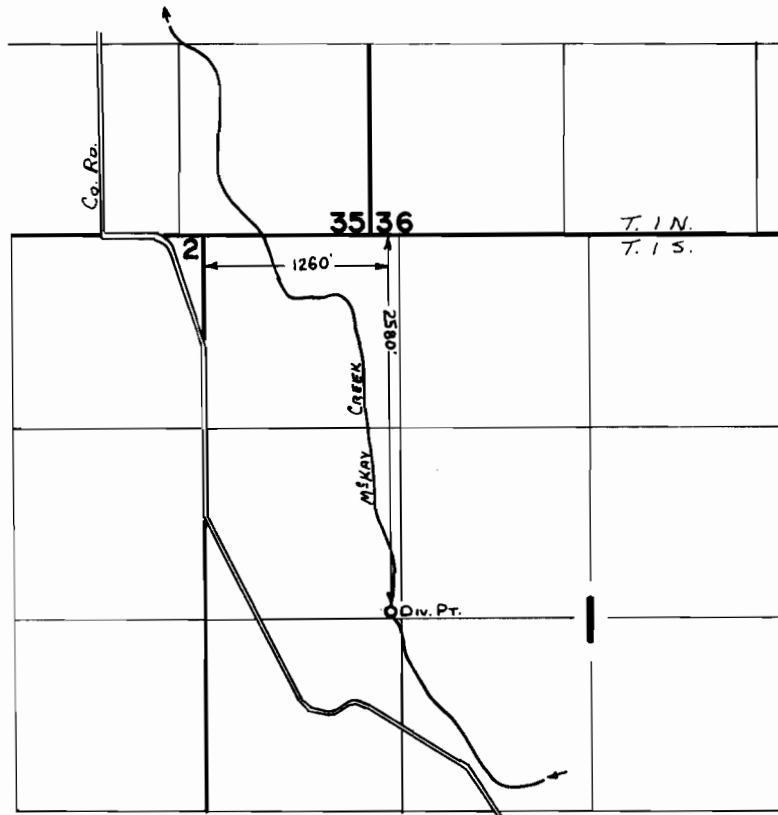

FINAL PROOF SURVEY UNDER

Transfer No. W-130
Application No. _____ Permit No. _____
IN NAME OF

ESTATE OF CARL WILSON

Surveyed Aug. 8 1974, by L. T. G. L.