


T.35S., R.4W., W.M.

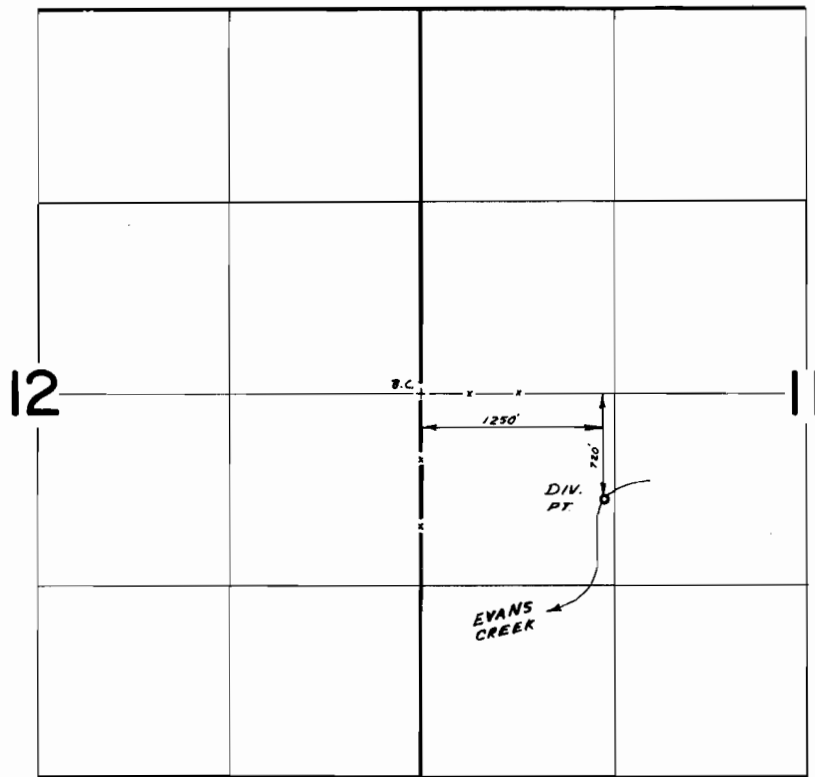

FINAL PROOF SURVEY
UNDER

Transfer No. W-146 & W-147
Application No. Permit No.
IN NAME OF

HARRY E. AND NORLENE WARDLE

Surveyed May 6 1975, by D. Norby