


T.18S. R.13E. W.M.

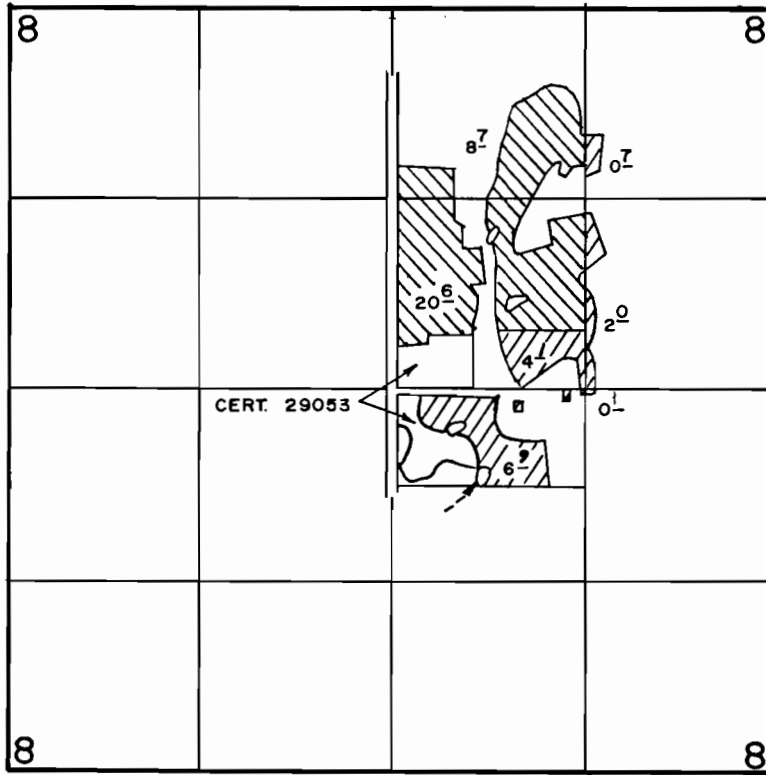

 TR. H-143
 TR. W-151

FINAL PROOF SURVEY

UNDER

TRANSFER H-143

PART OF TRANSFER W-151

Application No. Permit No.

IN NAME OF

..... CURTIS O. BANEY

Surveyed AUG. 20. 1980., by L.H. NUNN.....