


SECTION

TOWNSHIP 37 S, RANGE 5 W, W. M.

4 W and

North

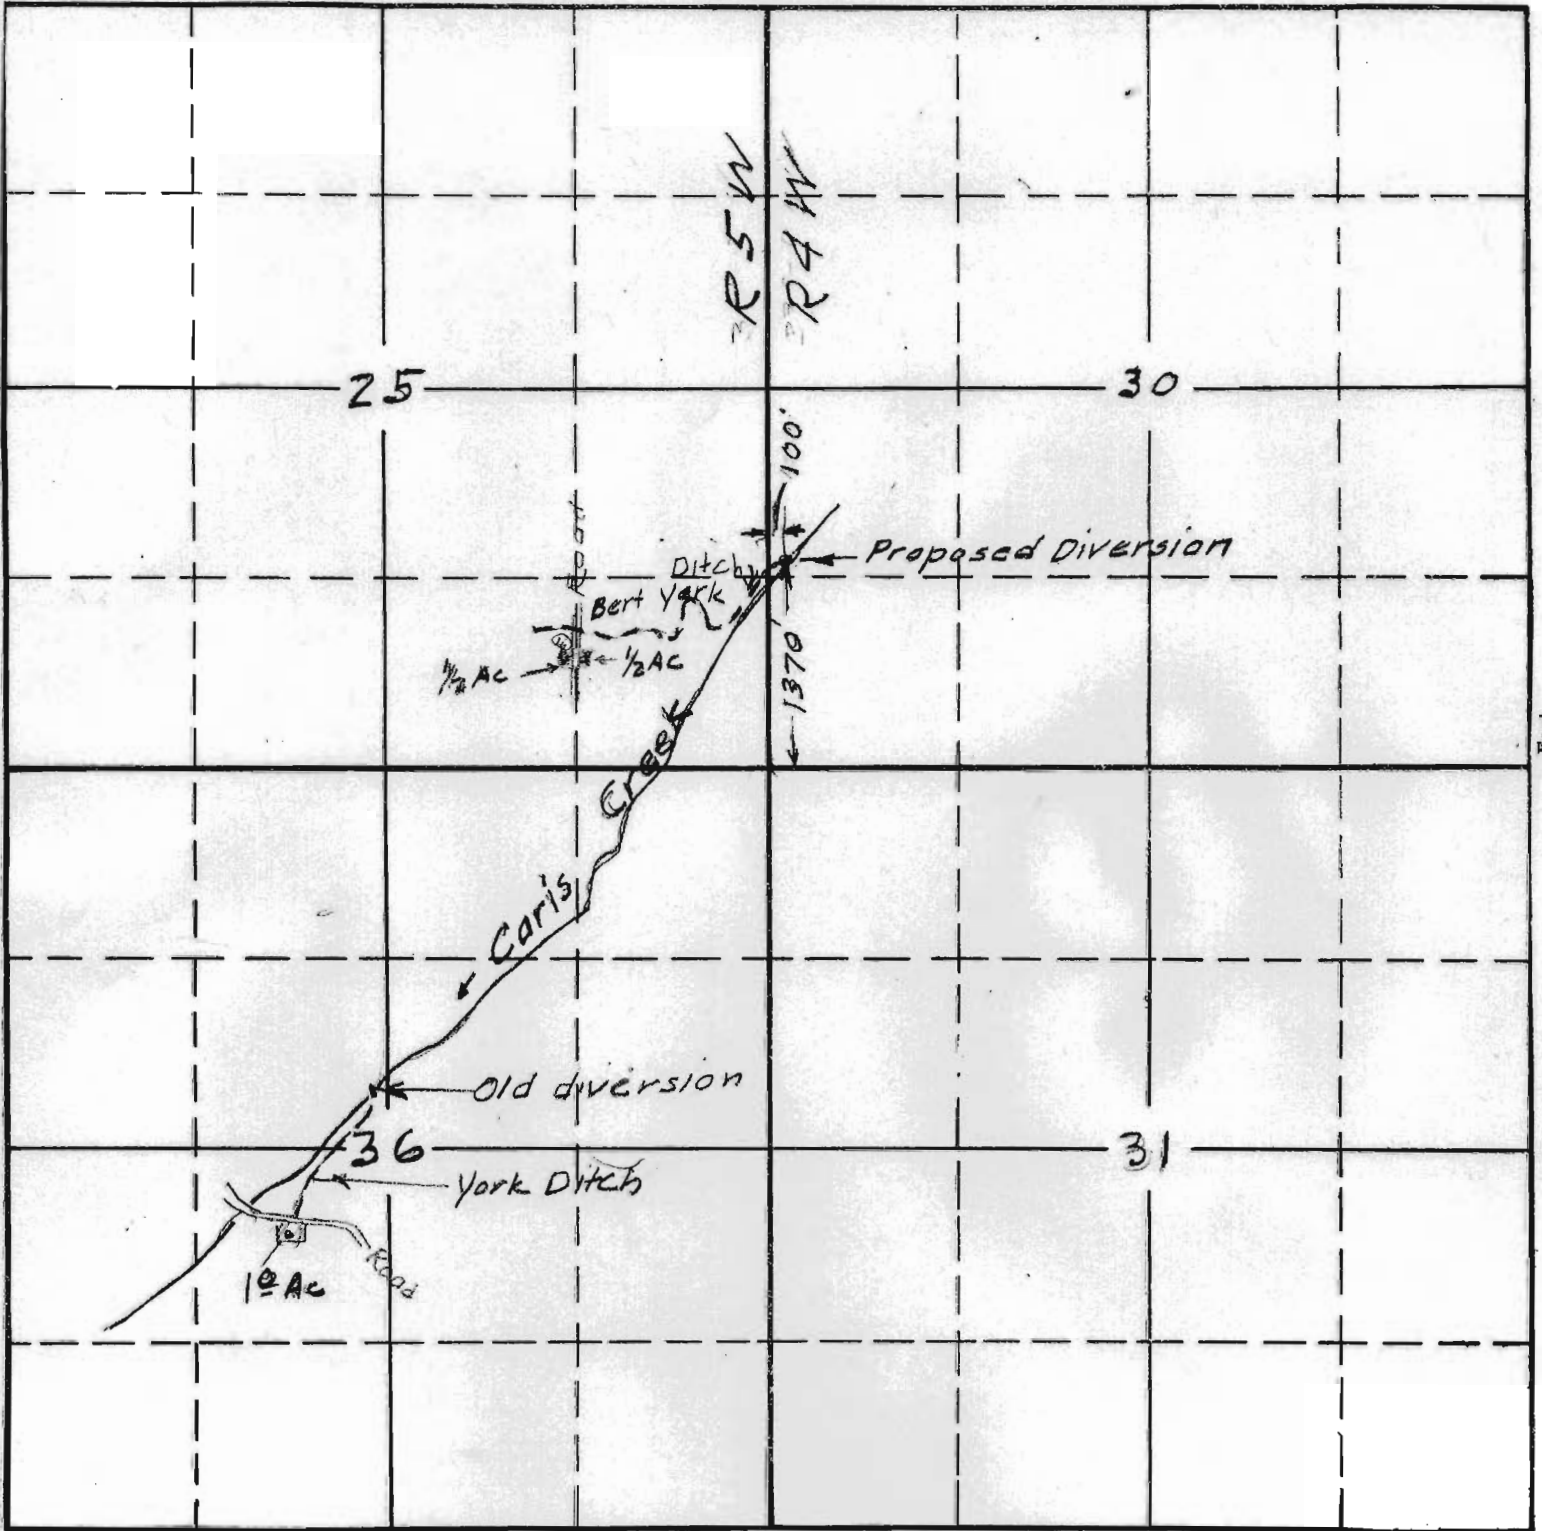

South

APPLICATION No.
PERMIT No.

RECEIVED

MAY 22 1941

STATE ENGINEER
SALEM, OREGON