


T. 4 S., R. 13 E., W.M.

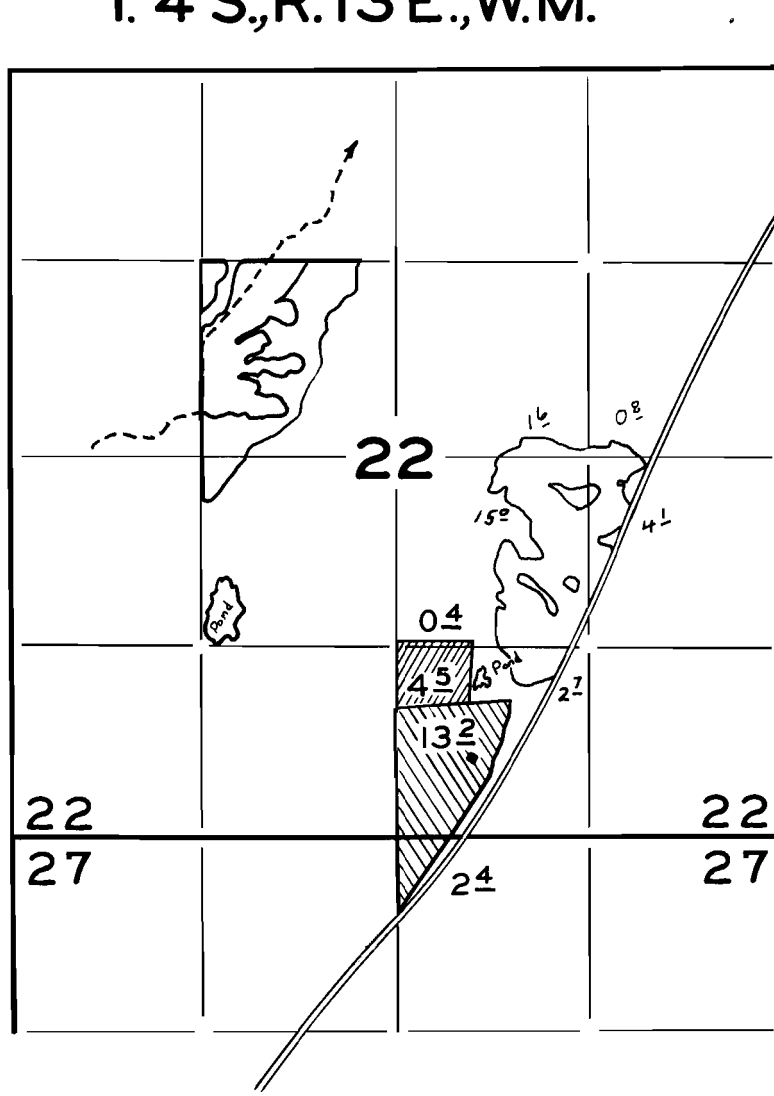

**FINAL PROOF SURVEY**  
UNDER

TRANSFER: Y - 6

IN NAME OF

**L. J. SCHREIBER**



Surveyed OCT. 4, 1960, by W. CARR



" NOV. 27, 1961 " W. CARR