


Exhibit "B"

Proposed use site

16 12 32

Z-8

Section 32, T.16 S. R.12 E. W.M.
DESCHUTES COUNTY
1" = 400'

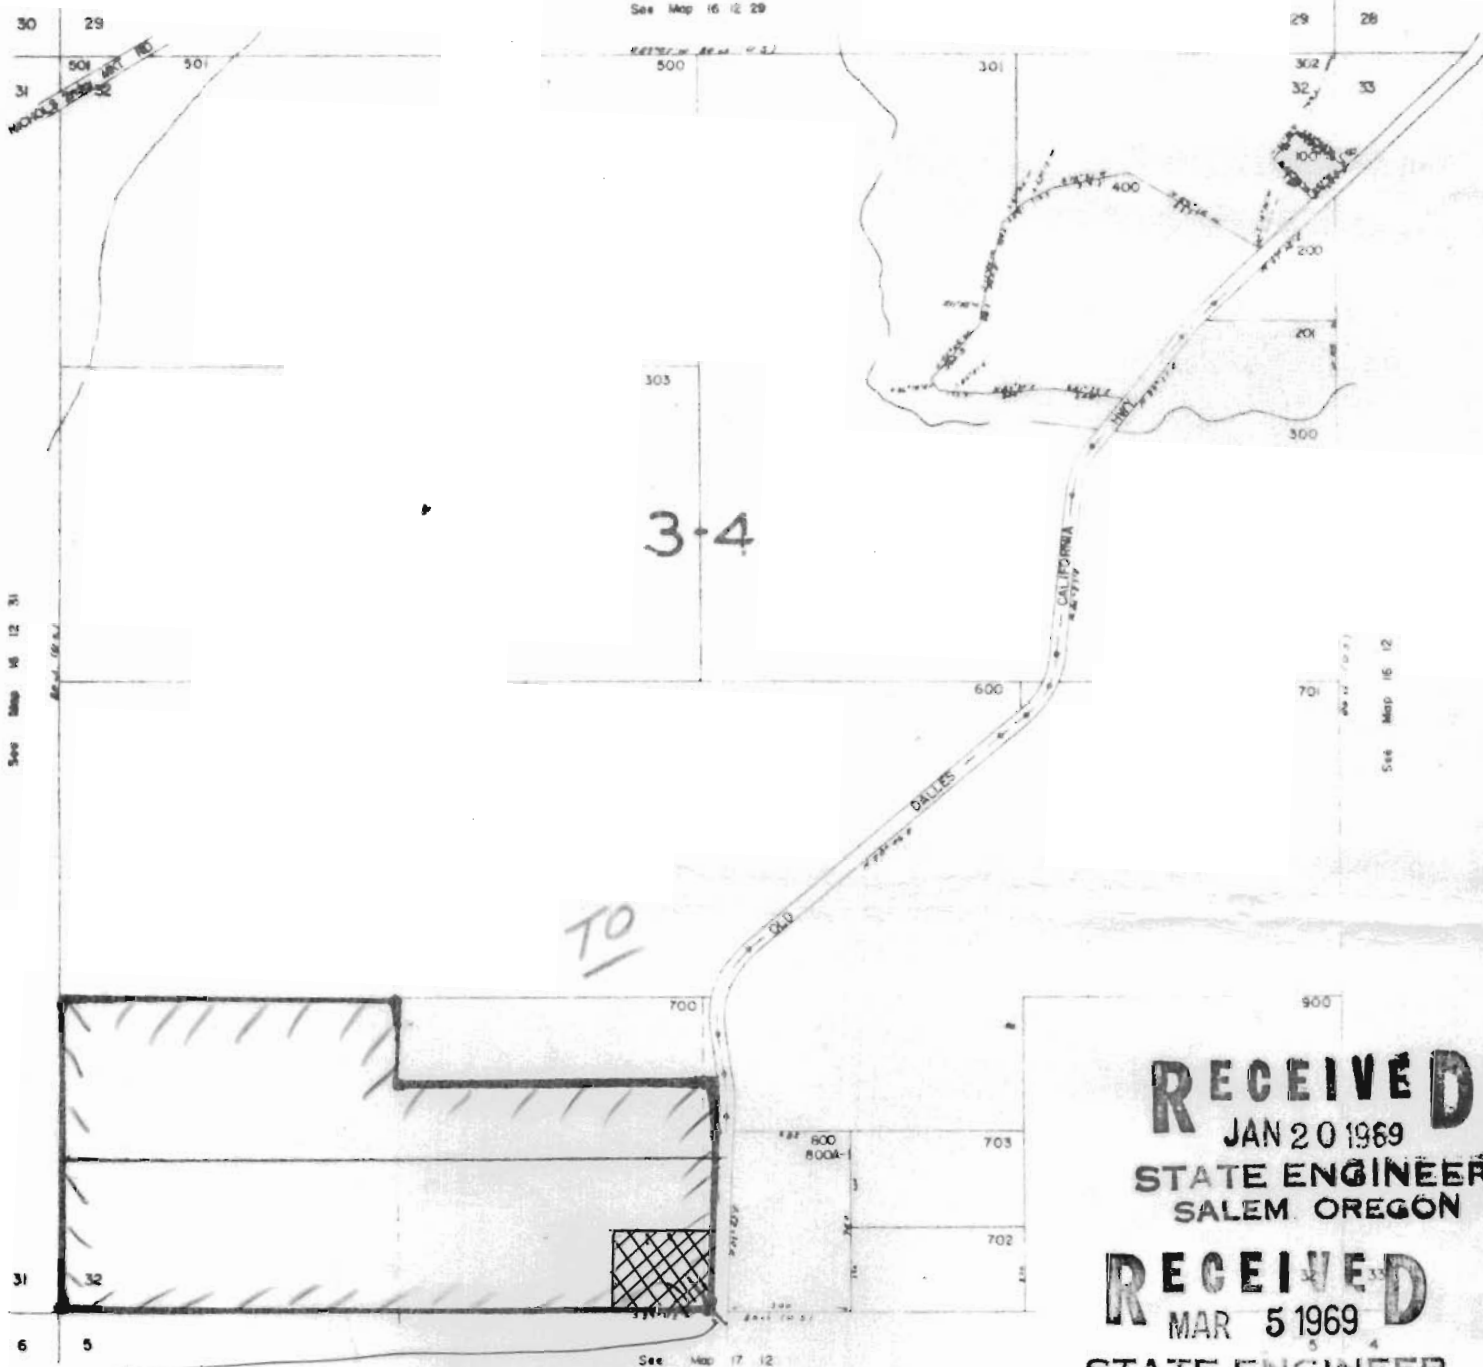

RECEIVED
JAN 20 1969
STATE ENGINEER
SALEM, OREGON

RECEIVED
MAR 5 1969
STATE ENGINEER
SALEM, OREGON

16 12

Township 16 South, Range 12 East, W.M., Deschutes County, Oregon
Section 32: S¹/₂SW¹/₄; and that portion of the SW¹/₄SE¹/₄ lying westerly
from the westerly right of way line of the old Dalles-California
Highway: EXCEPTING THEREFROM the NE¹/₂SE¹/₄SW¹/₄ and that portion
of the N¹/₂NW¹/₄SW¹/₄SE¹/₄ lying westerly of the westerly right of way
line of the old Dalles-California Highway. All other rights reserved.
less.

Point of diversion →

RECEIVED
AUG 21 1968
STATE ENGINEER
SALEM, OREGON

RECEIVED
JUL 23 1968
STATE ENGINEER
SALEM, OREGON