


# William McDaniel and Suzie McDaniel: Water Right Application Map

THIS MAP WAS PREPARED FOR  
ASSESSMENT PURPOSE ONLY

NE1/4 NW1/4 SEC. 9 T23S R12 W.M  
COOS COUNTY  
1" = 100'


23 12 09BA  
CANCELLED NO.

RECEIVED  
RECEIVED  
SEP. 12 2022  
OWRD

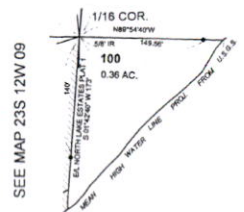

SEE MAP 23S 12W 09

SEE MAP 23S 12W 09

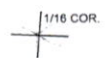

1" = 200'


LAKE  
TENMILE  
NORTH

13-04F  
13-02

NORTH  
TENMILE Lake

SEE MAP 23S 12W 04CD

SEE MAP 23S 1W2 09

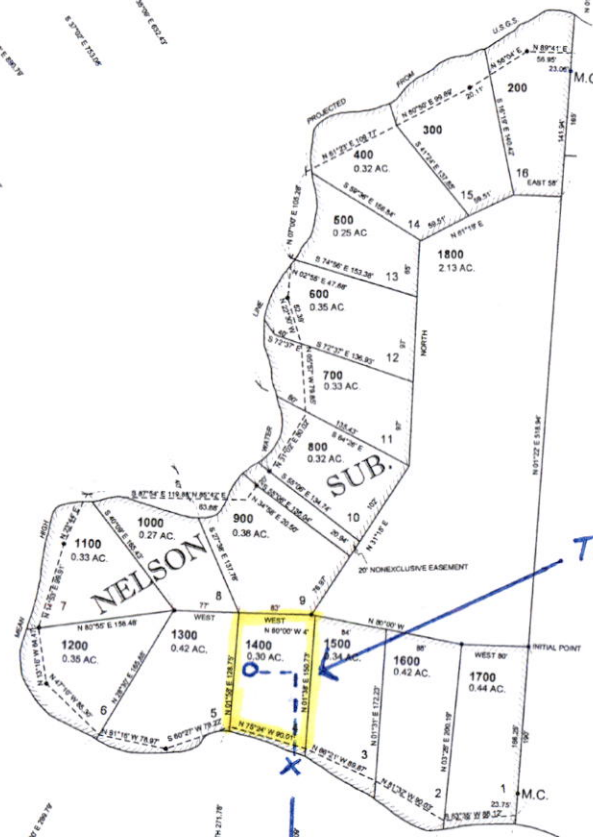

SEE MAP 23S 12W 09

Tax Lot 23S12W09 BA TL 1400

X Pump  
--- Water line  
O Tank

200 ft north  
of 1/16 corner

225 ft East  
of 1/16 corner

pump is 300 ft  
from this 1/16 corner

23 12 09BA

North

quarter corner